


Midship Section No 156 S.S. "Ping Suey"  
 To Class 100 A1 3 decks Steel  
 Scale  $\frac{1}{2}$  = one foot  
 [Duplicate of Yangtze Belfast Report No 4976]

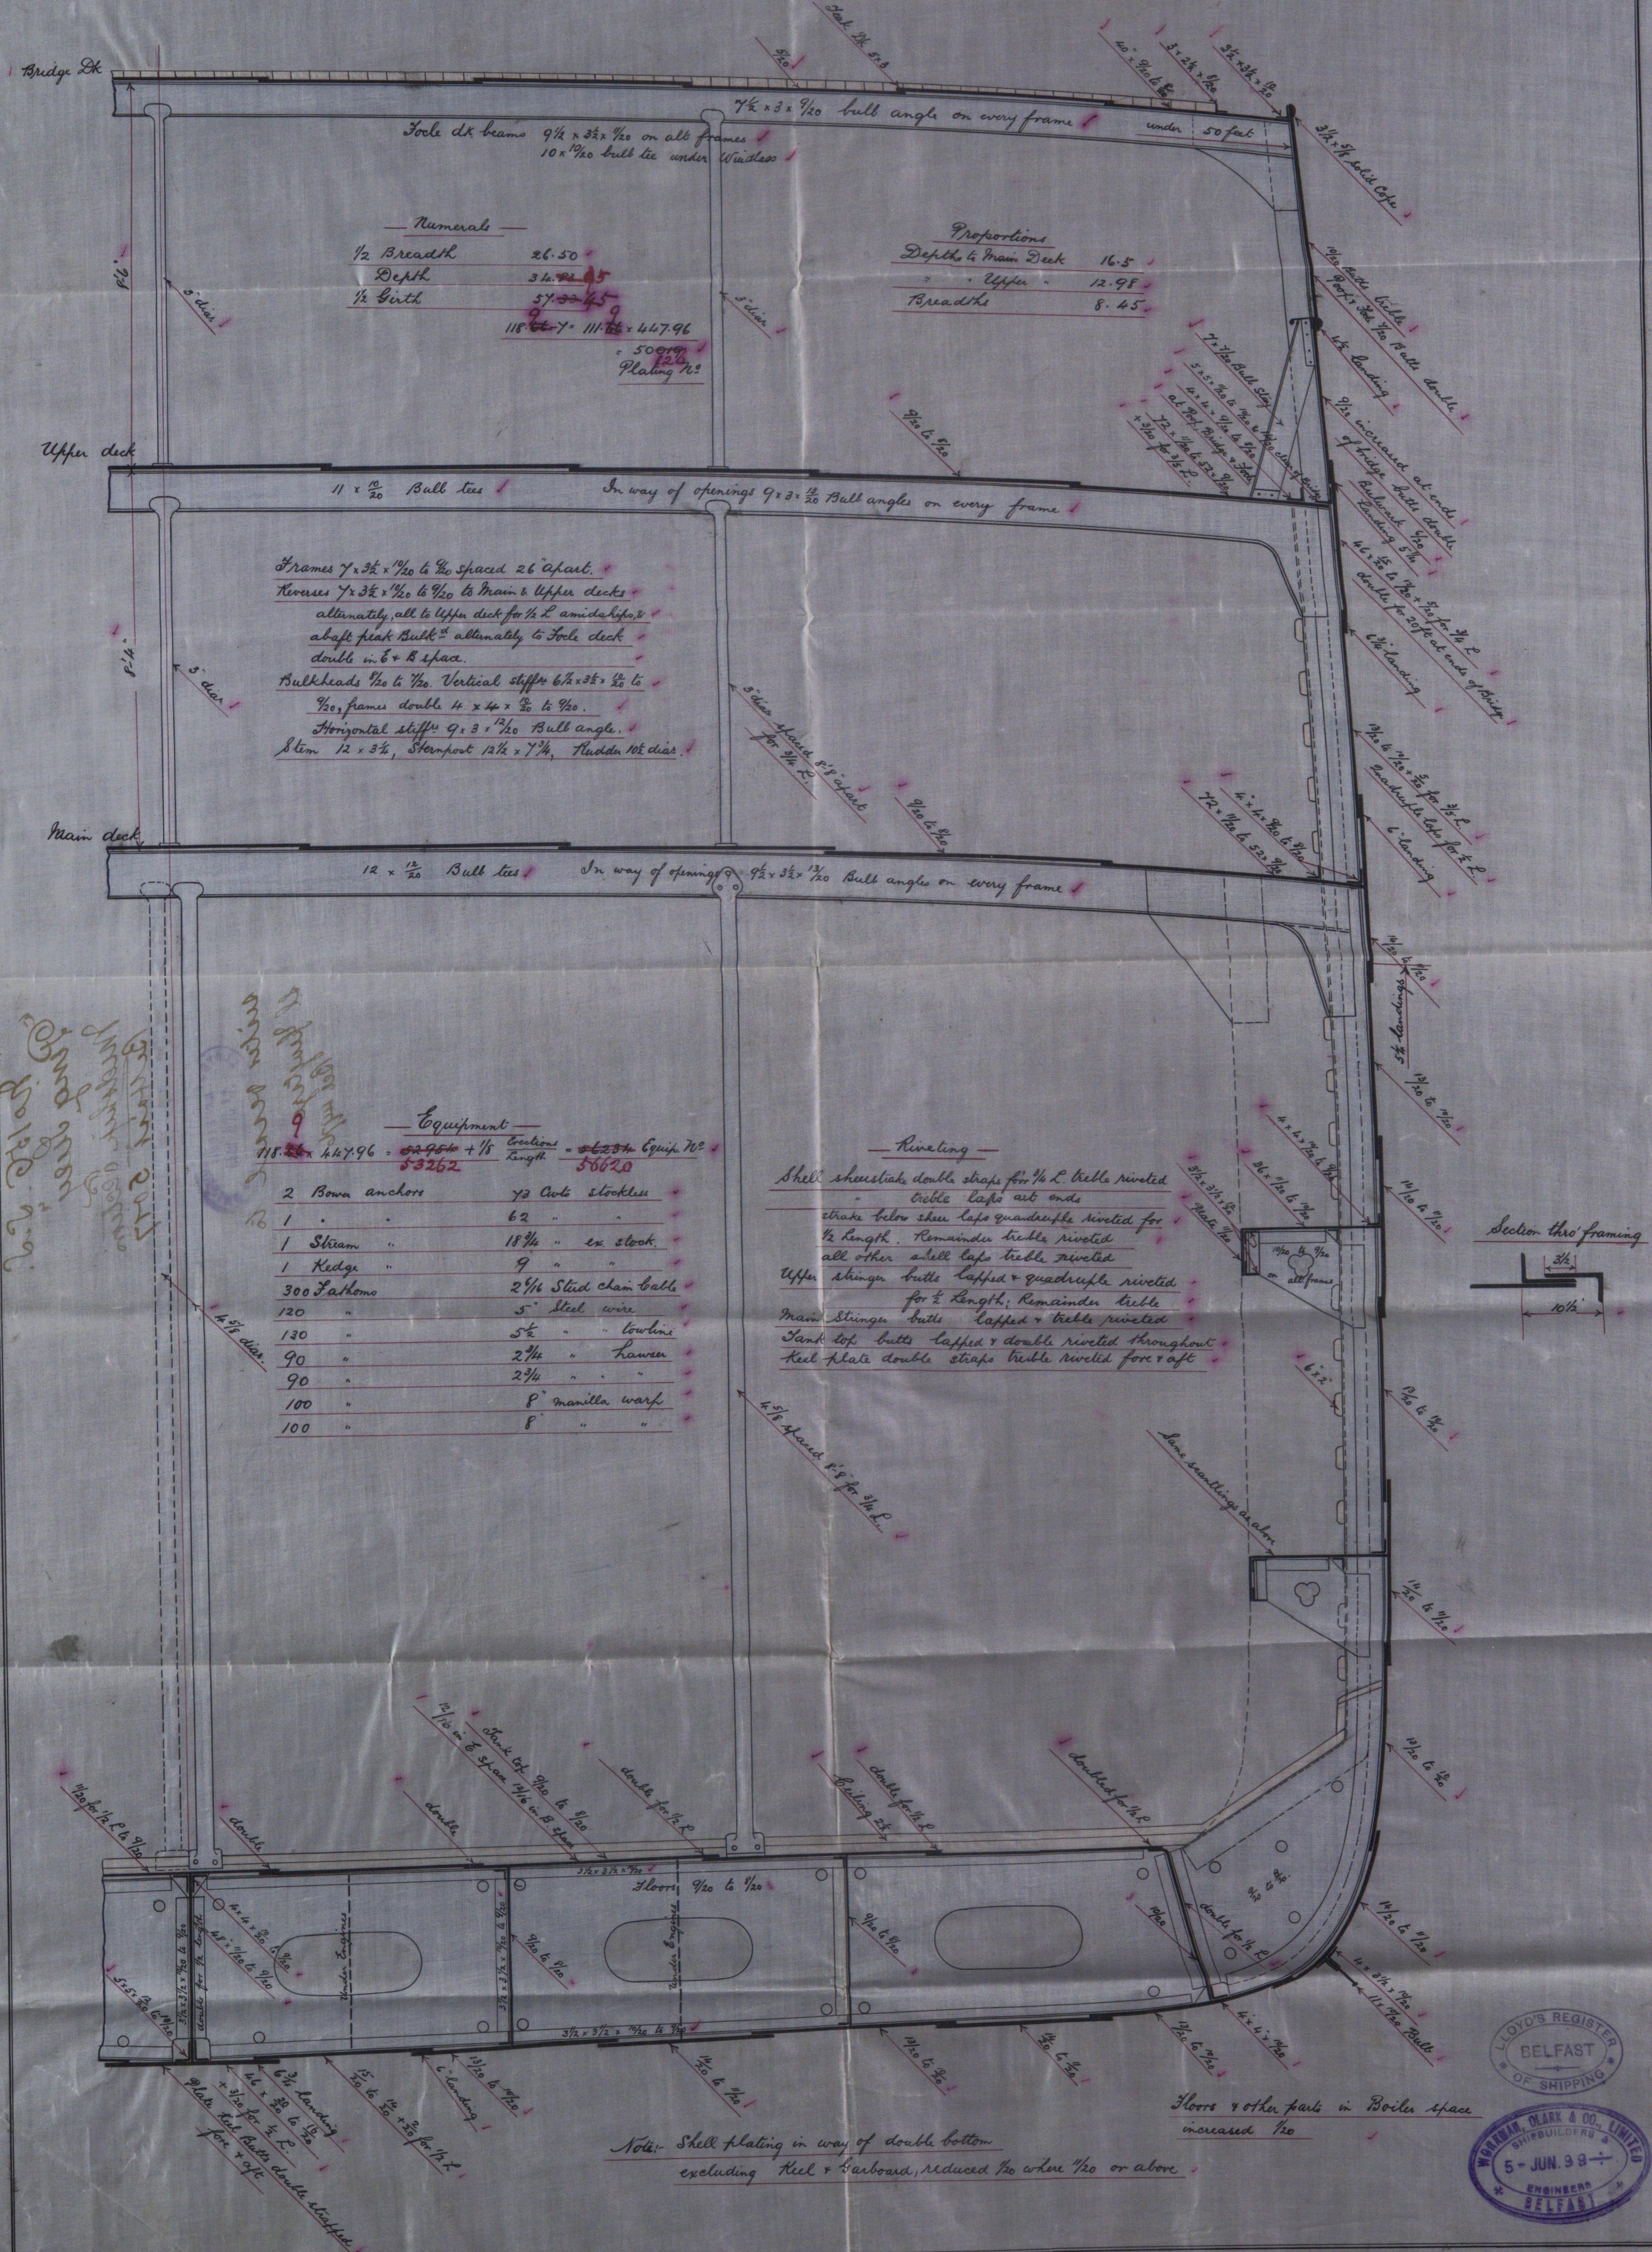

Belfast  
Workman Clark & C<sup>o</sup>  
No 156. S.S.  
Ping Suey  
Midship Section  
Belfast 5017

sister vessel to  
St. Gavijo  
See 4476

