

For the information of Surveyors and the Committee only.

Received at

Belfast

Office.

8/6/99

1899

Lloyd's Register of British and Foreign Shipping.

(Report on Vessel No. _____ Port _____)

No. 7014 SHIP FORGINGS OR CASTINGS.

The words FORGINGS or CASTINGS, IRON or STEEL, should be struck out as may be required.

I have to report that the undermentioned Iron or Steel Forgings or Castings, manufactured by Mess Matthew Reid & Co of Kilmarnock for the Vessel No. 45, being built by The Londonderry & B Co of Londonderry have been inspected by me as set forth below, and found to be, so far as can be seen, Sound & efficient

Mark on Forgings.

Lloyd's


No. 7014

W.H.

William Hamilton
Glasgow


	STERN FRAME.	RUDDER FRAME.	STEM.
Material* ...	Scrap iron		Scrap iron
How made ...	Forged		Forged
Dimensions ...	11 ft 6 1/2		11 ft 2 3/4
Progress on Inspection	Forging & smithing		Forging
Date when Inspected	30/3/99 to 2/6/99		29. 30/5/99

SKETCHES OF FRAMES SHOWING POSITION AND DESCRIPTION OF WELDS OF FORGINGS, OR PARTICULARS OF TESTS APPLIED TO CASTINGS.

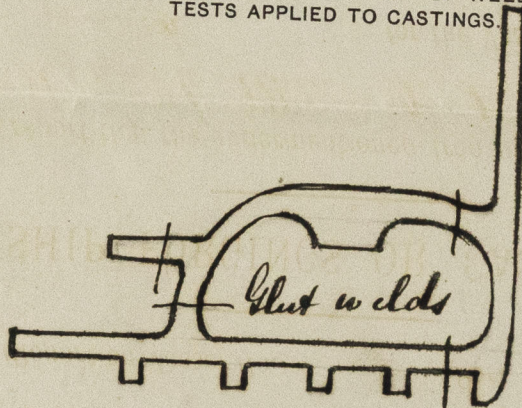

Fee (if any chargeable) £

To be paid at

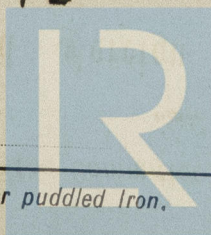

© 2019

Lloyd's Register
Foundation

BEL10-0082

Londonderry & Co Coy

43

Stern Frame & Stern
Ship forgings.

8/6/99

S. S. "Marle"

Report No. 5114

© 2019

Lloyd's Register
Foundation