


Belfast
Workman Clark & Co
No 166
Midship Section

500 x 59 x 36.6
T.S.S. "IRADA"

Report No 5151

BELT-0191

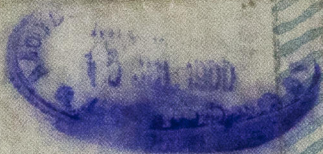

© 2019

Lloyd's Register
Foundation

Midship Section of Twin Screw Steamer.

500.0 x 59.0 x 36.6 m³

To Class 10041 Lloyds. - Three Decks

No 166

Scale 1/2 inch = one foot.

15.2.99
10.3.99
3.5.99
13.5.99
25.5.99
31.5.99
8.6.99
4.10.99
11.6.00

