


— Scale  $\frac{1}{2}'' = 1 \text{ Foot.}$  —

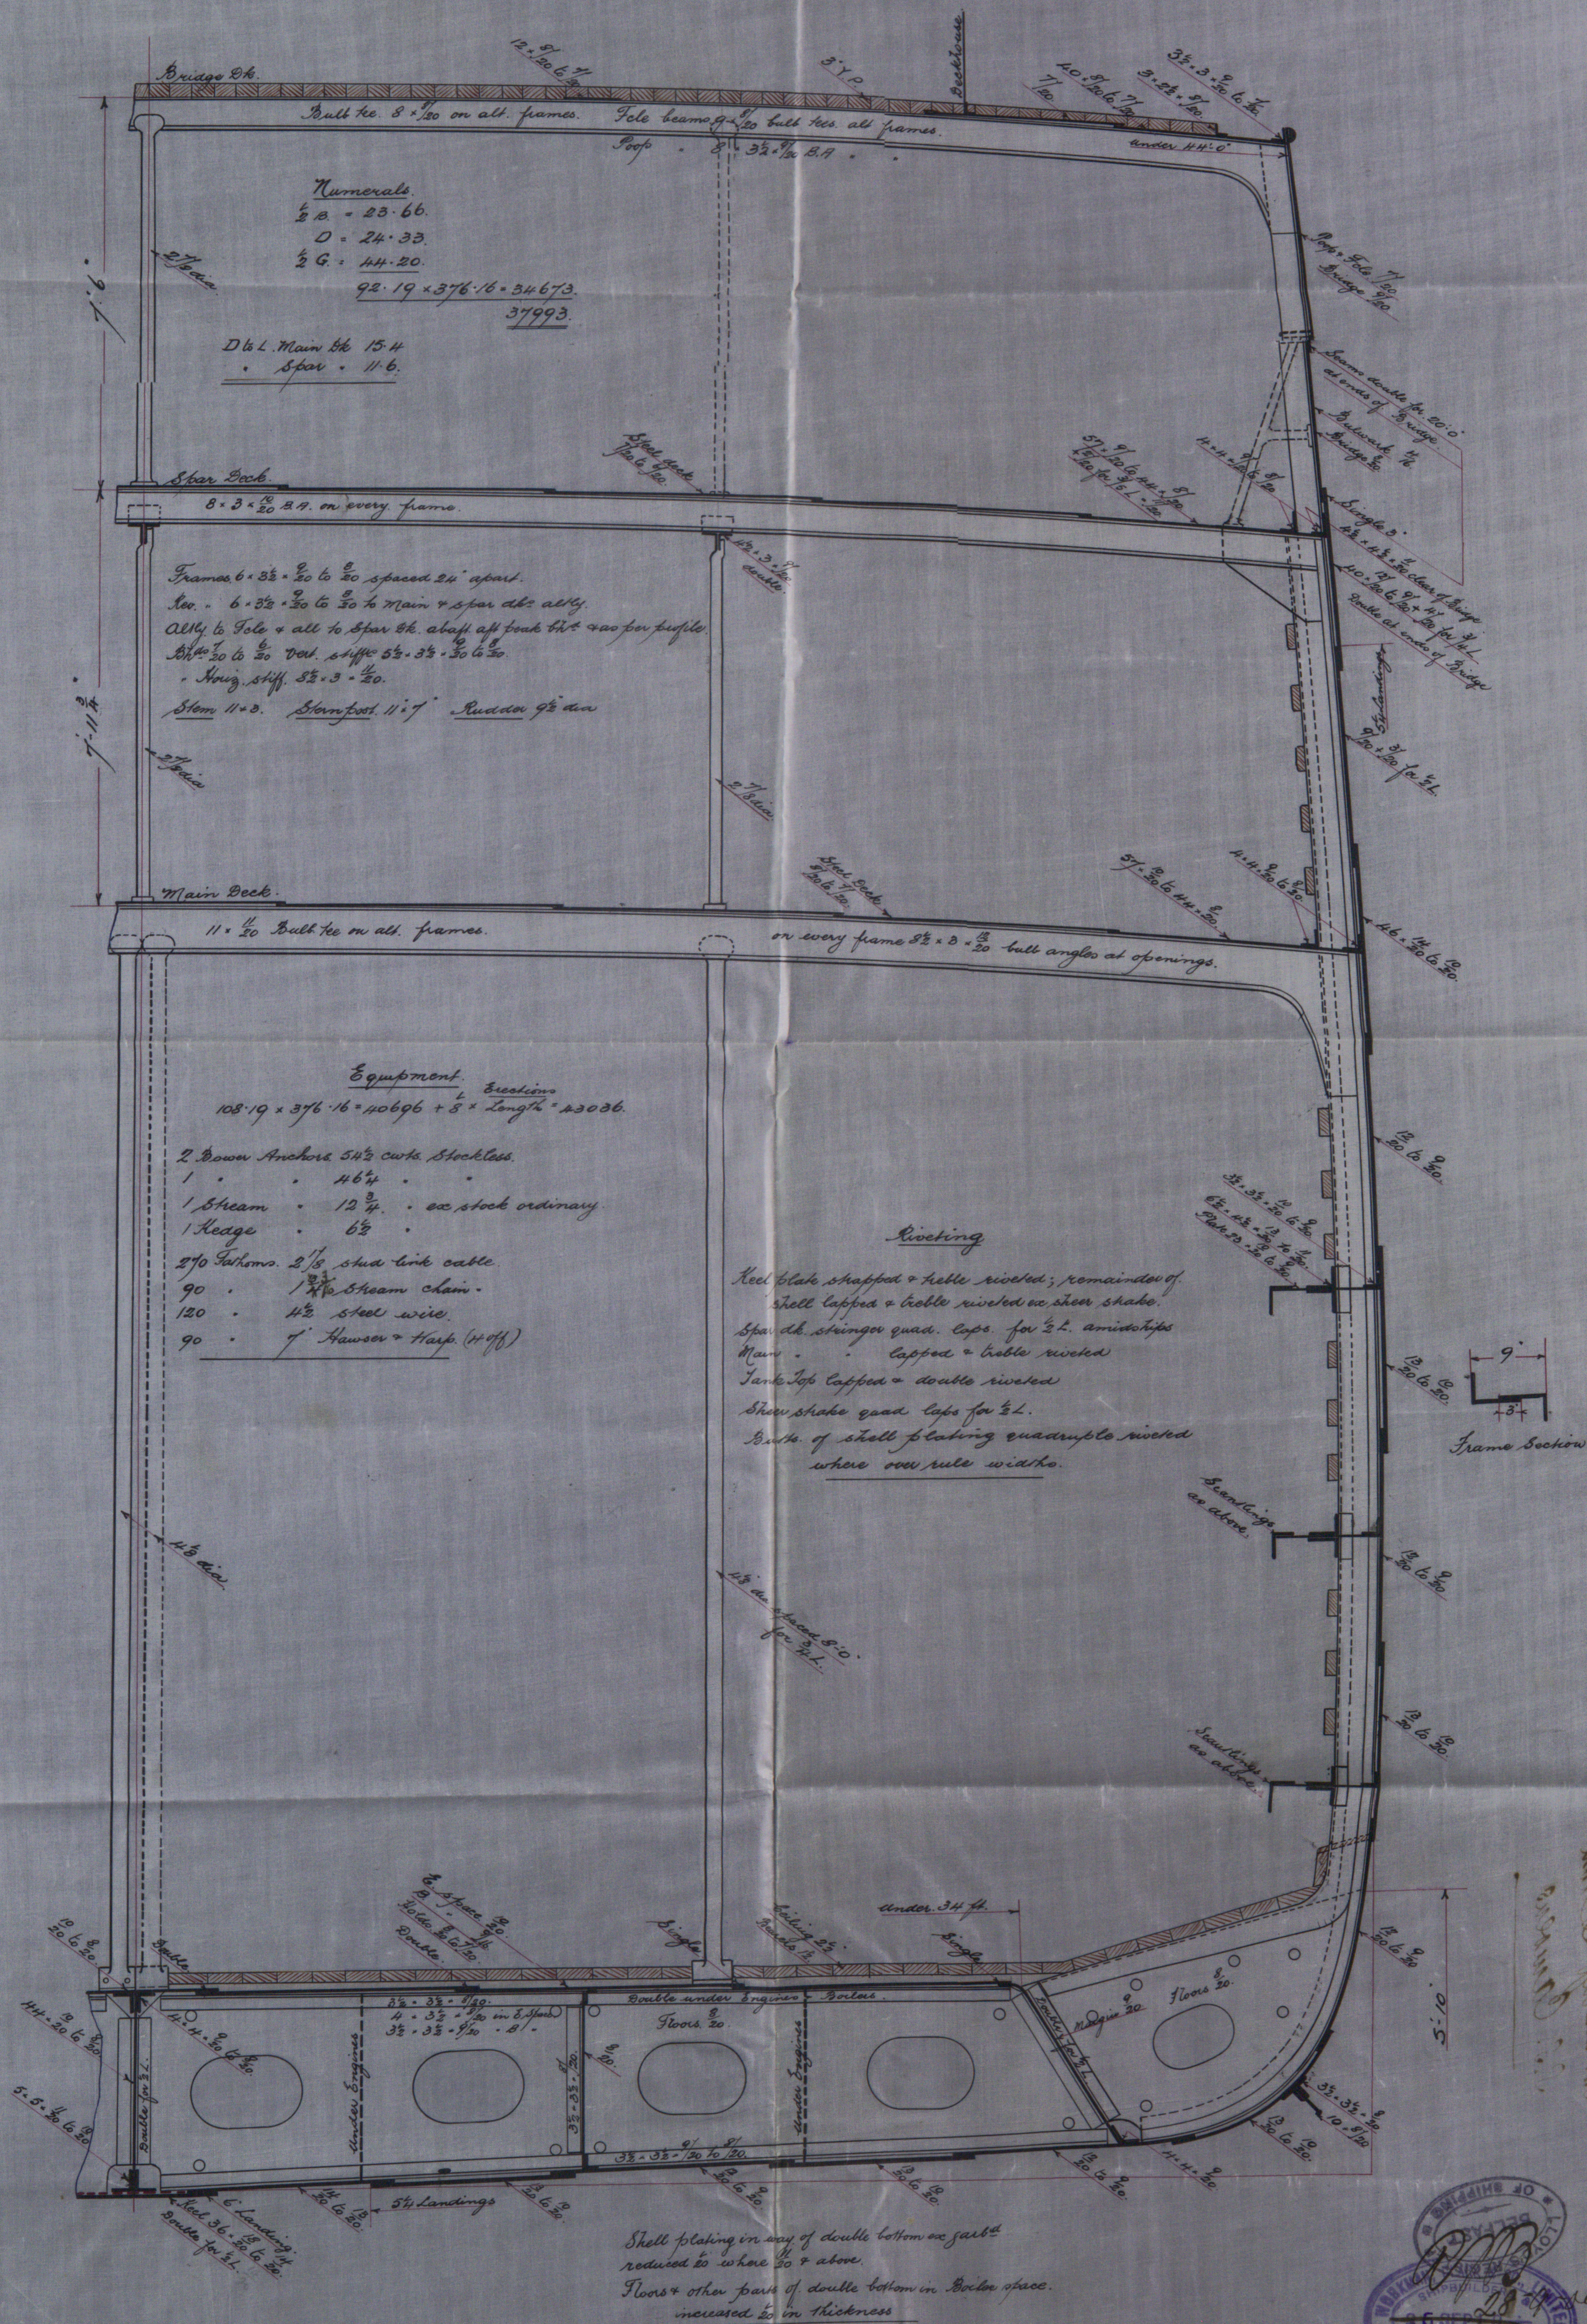

1842  
 1843  
