

## Lloyd's Register of British and Foreign Shipping.

(Report on Vessel No. \_\_\_\_\_ Port \_\_\_\_\_)

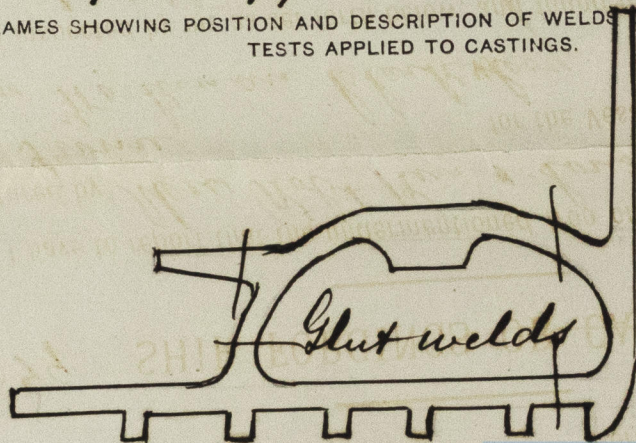
No. **4079** SHIP FORGINGS OR CASTINGS.

I have to report that the undermentioned Iron or Steel Forgings or Castings,  
 manufactured by *Mess Robt Kerr & Sons*  
 of *Irvine* for the Vessel No. *168*, being built  
 by *Mess Workman Clark & Co* *Belfast*  
 have been inspected by me as set forth below, and found to be, so far as can be seen,  
*Sound & efficient*

Mark on Forgings.

 Lloyd's  
 No. **4079**
*William Hamilton*  
*Glasgow*

	STERN FRAME.	RUDDER FRAME.	STEM.
Material*	<i>Scrap iron</i>		<i>Scrap iron</i>
How made	<i>Forged</i>		<i>Forged</i>
Dimensions	<i>11x4</i>		<i>11x3</i>
Progress on Inspection	<i>Forging &amp; smithing</i>		<i>Forging</i>
Date when Inspected	<i>10/8/99 to 1/2/00</i>		<i>25/12/99</i>

 SKETCHES OF FRAMES SHOWING POSITION AND DESCRIPTION OF WELDS OF FORGINGS, OR PARTICULARS OF  
 TESTS APPLIED TO CASTINGS.


Fee (if any chargeable) £ : :

To be paid at \_\_\_\_\_



Post  
Northman Clark & Co. S.S. 168

Letter Post  
S.S. "Camões"

© 2019

Lloyd's Register  
Foundation