


# *Stern Frame N<sup>o</sup> 170 T.S.S.*

*Scale 1 inch = 1 Foot.*

3.8.99

3.8.99

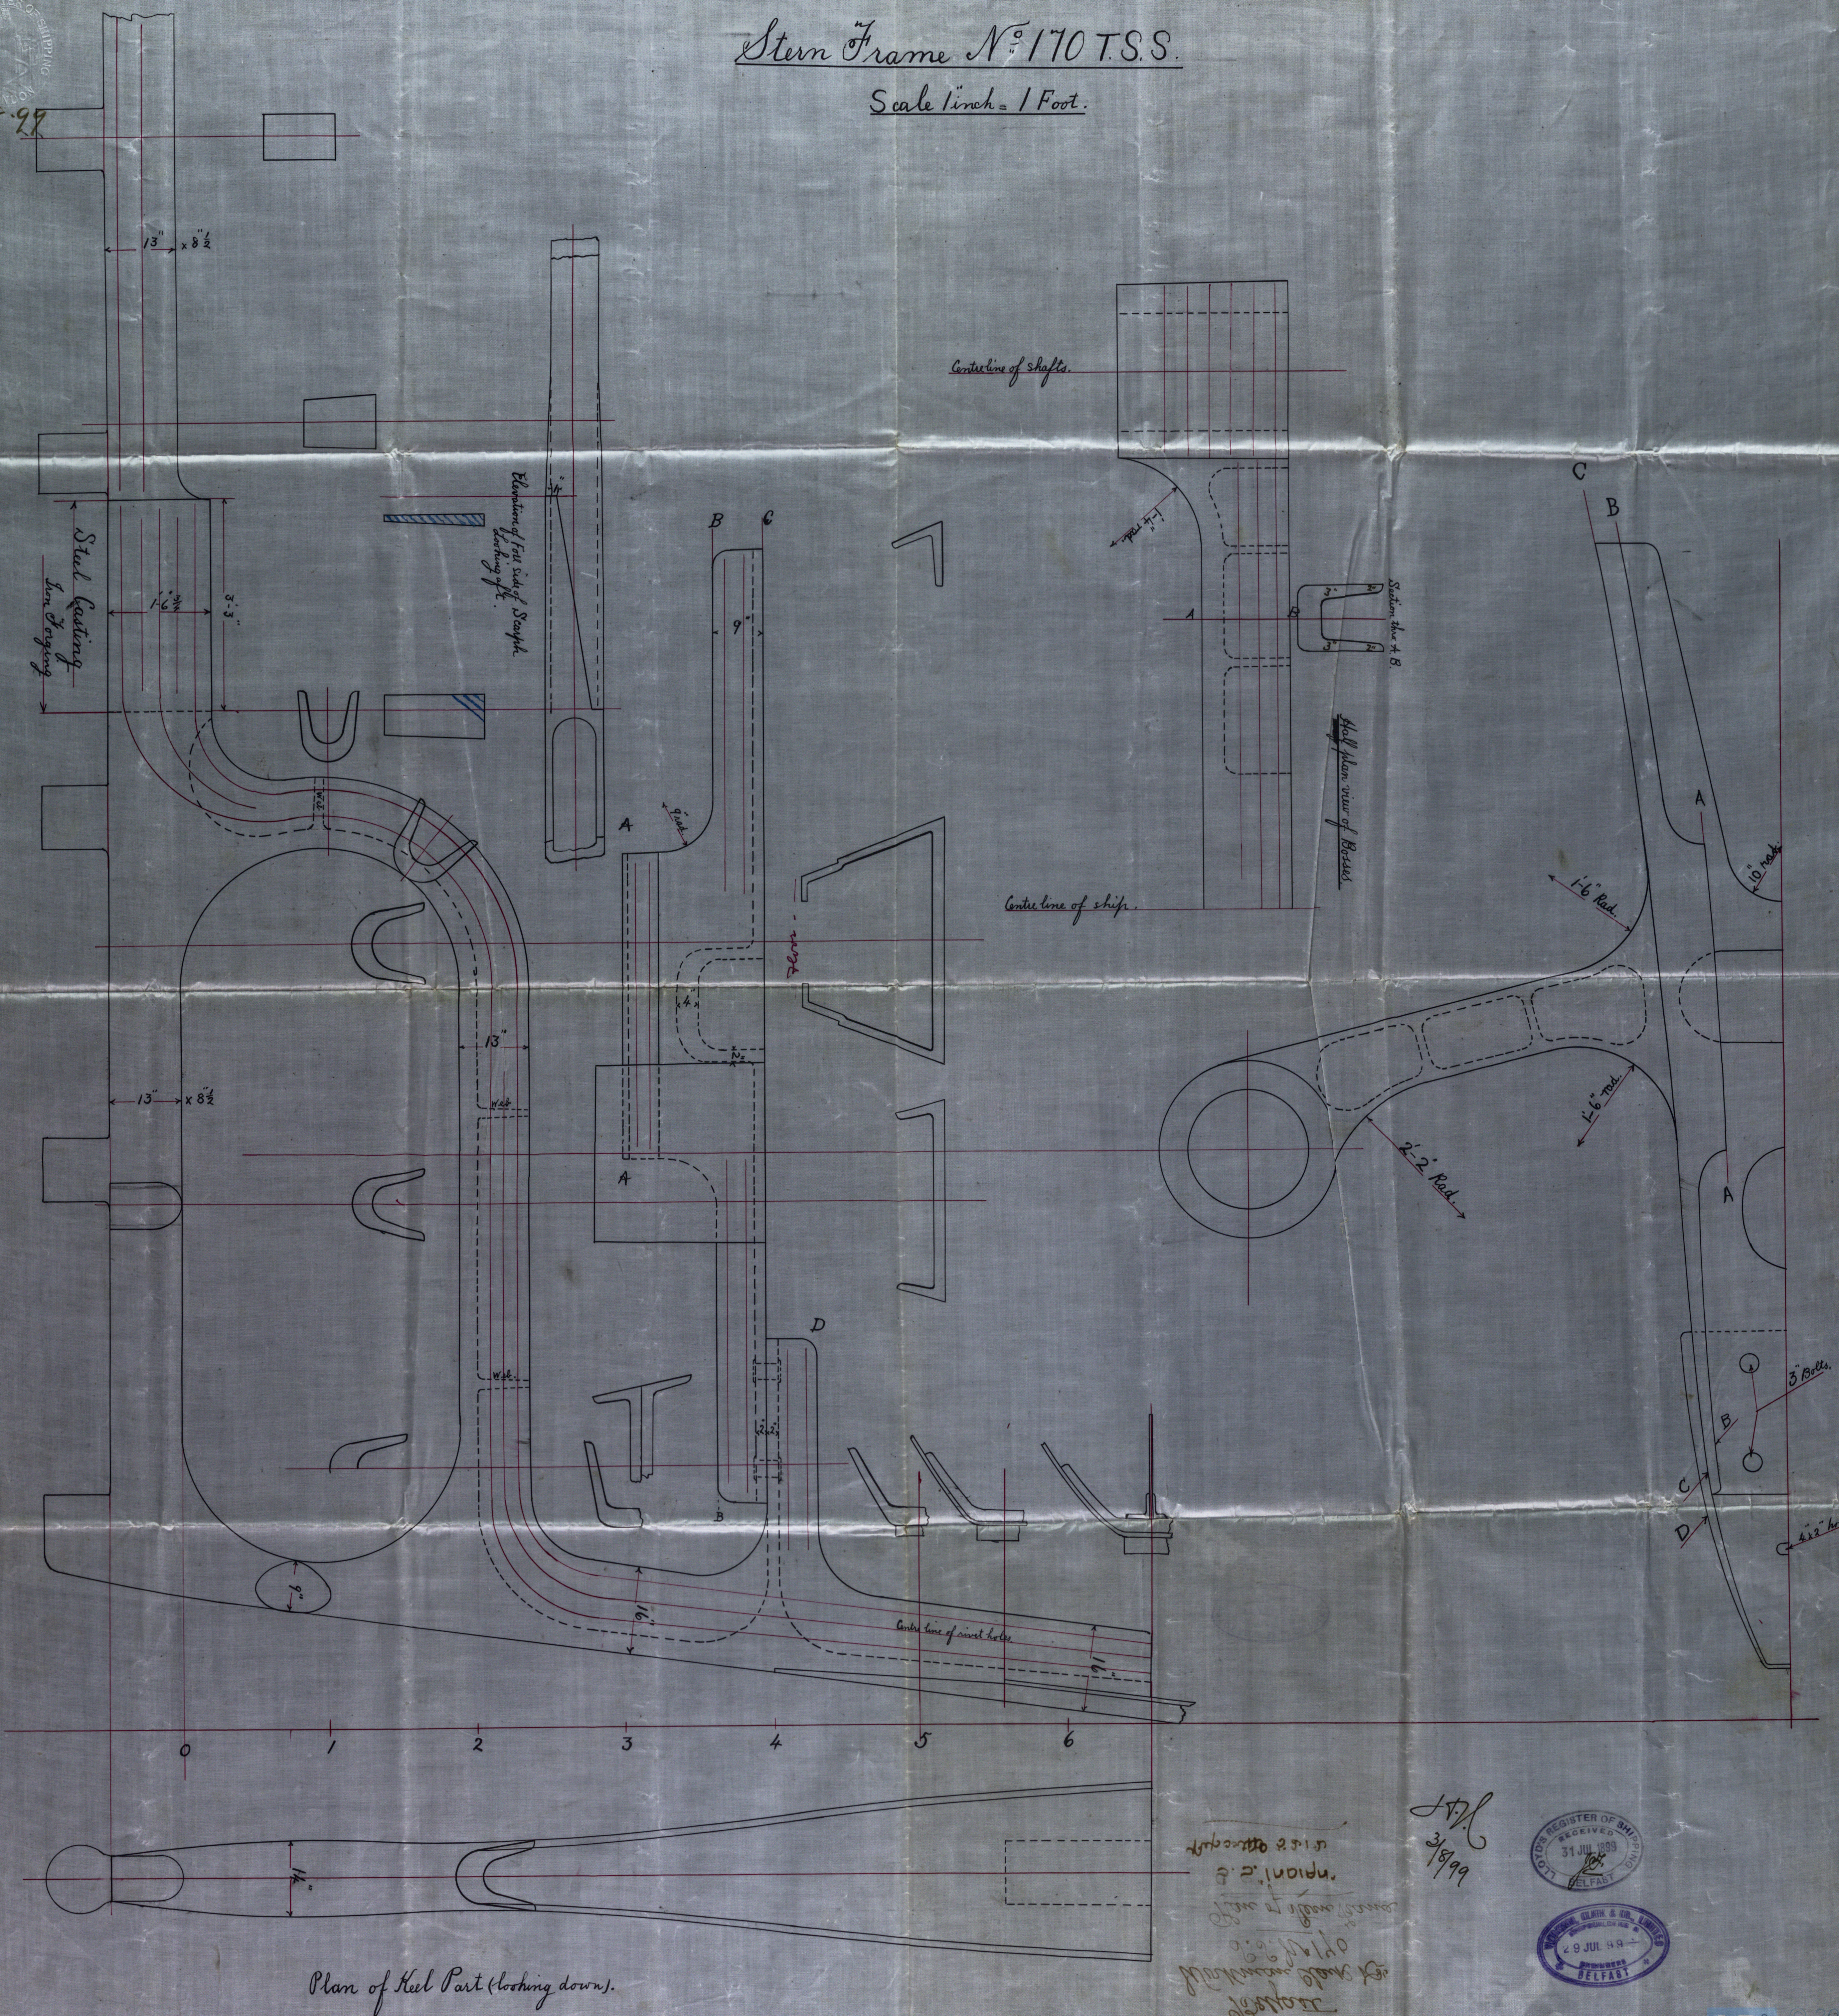

Handwritten notes and signatures at the bottom right of the drawing.

Handwritten signature and date: 3/8/99.







Belfast  
Workman Clark & Co.  
S.S. No 140

Plan of Stern Frame  
S.S. "INDIAN"

Report No 5212

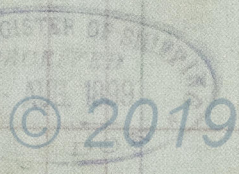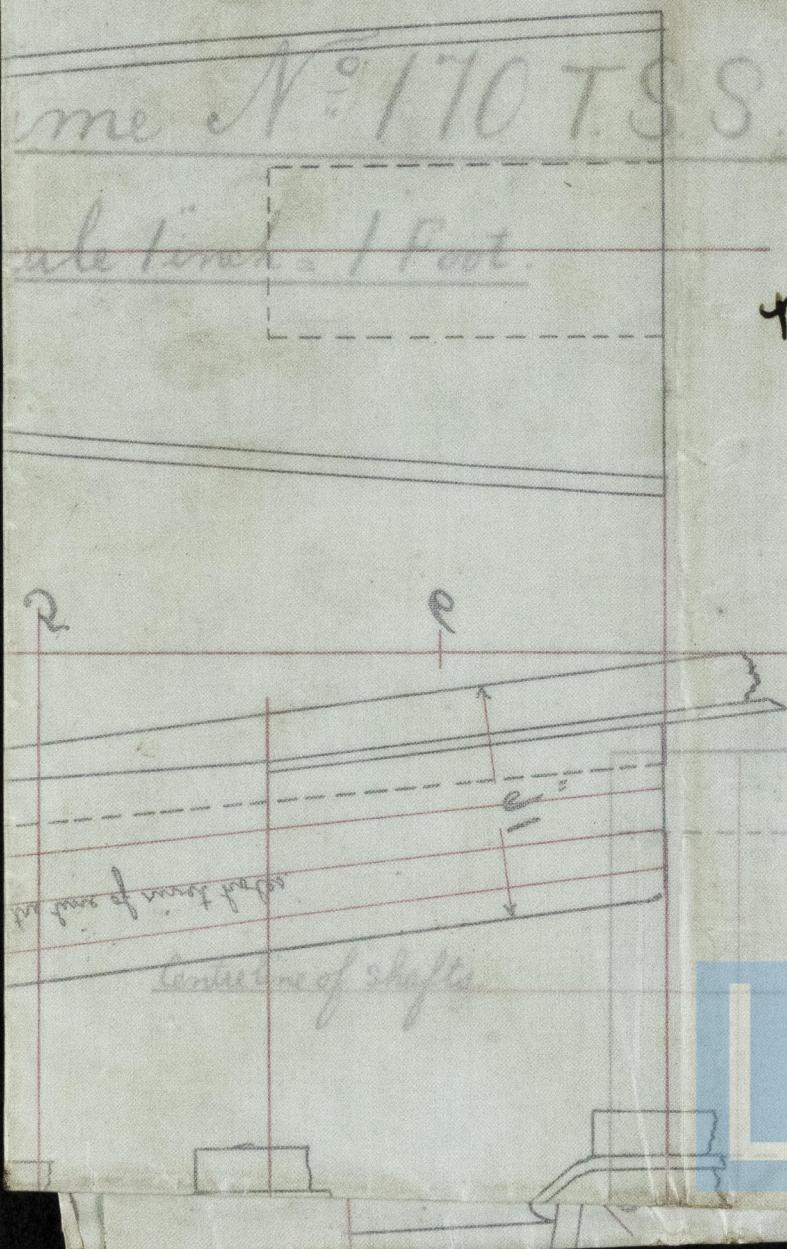

© 2019  
Lloyd's Register  
Foundation