
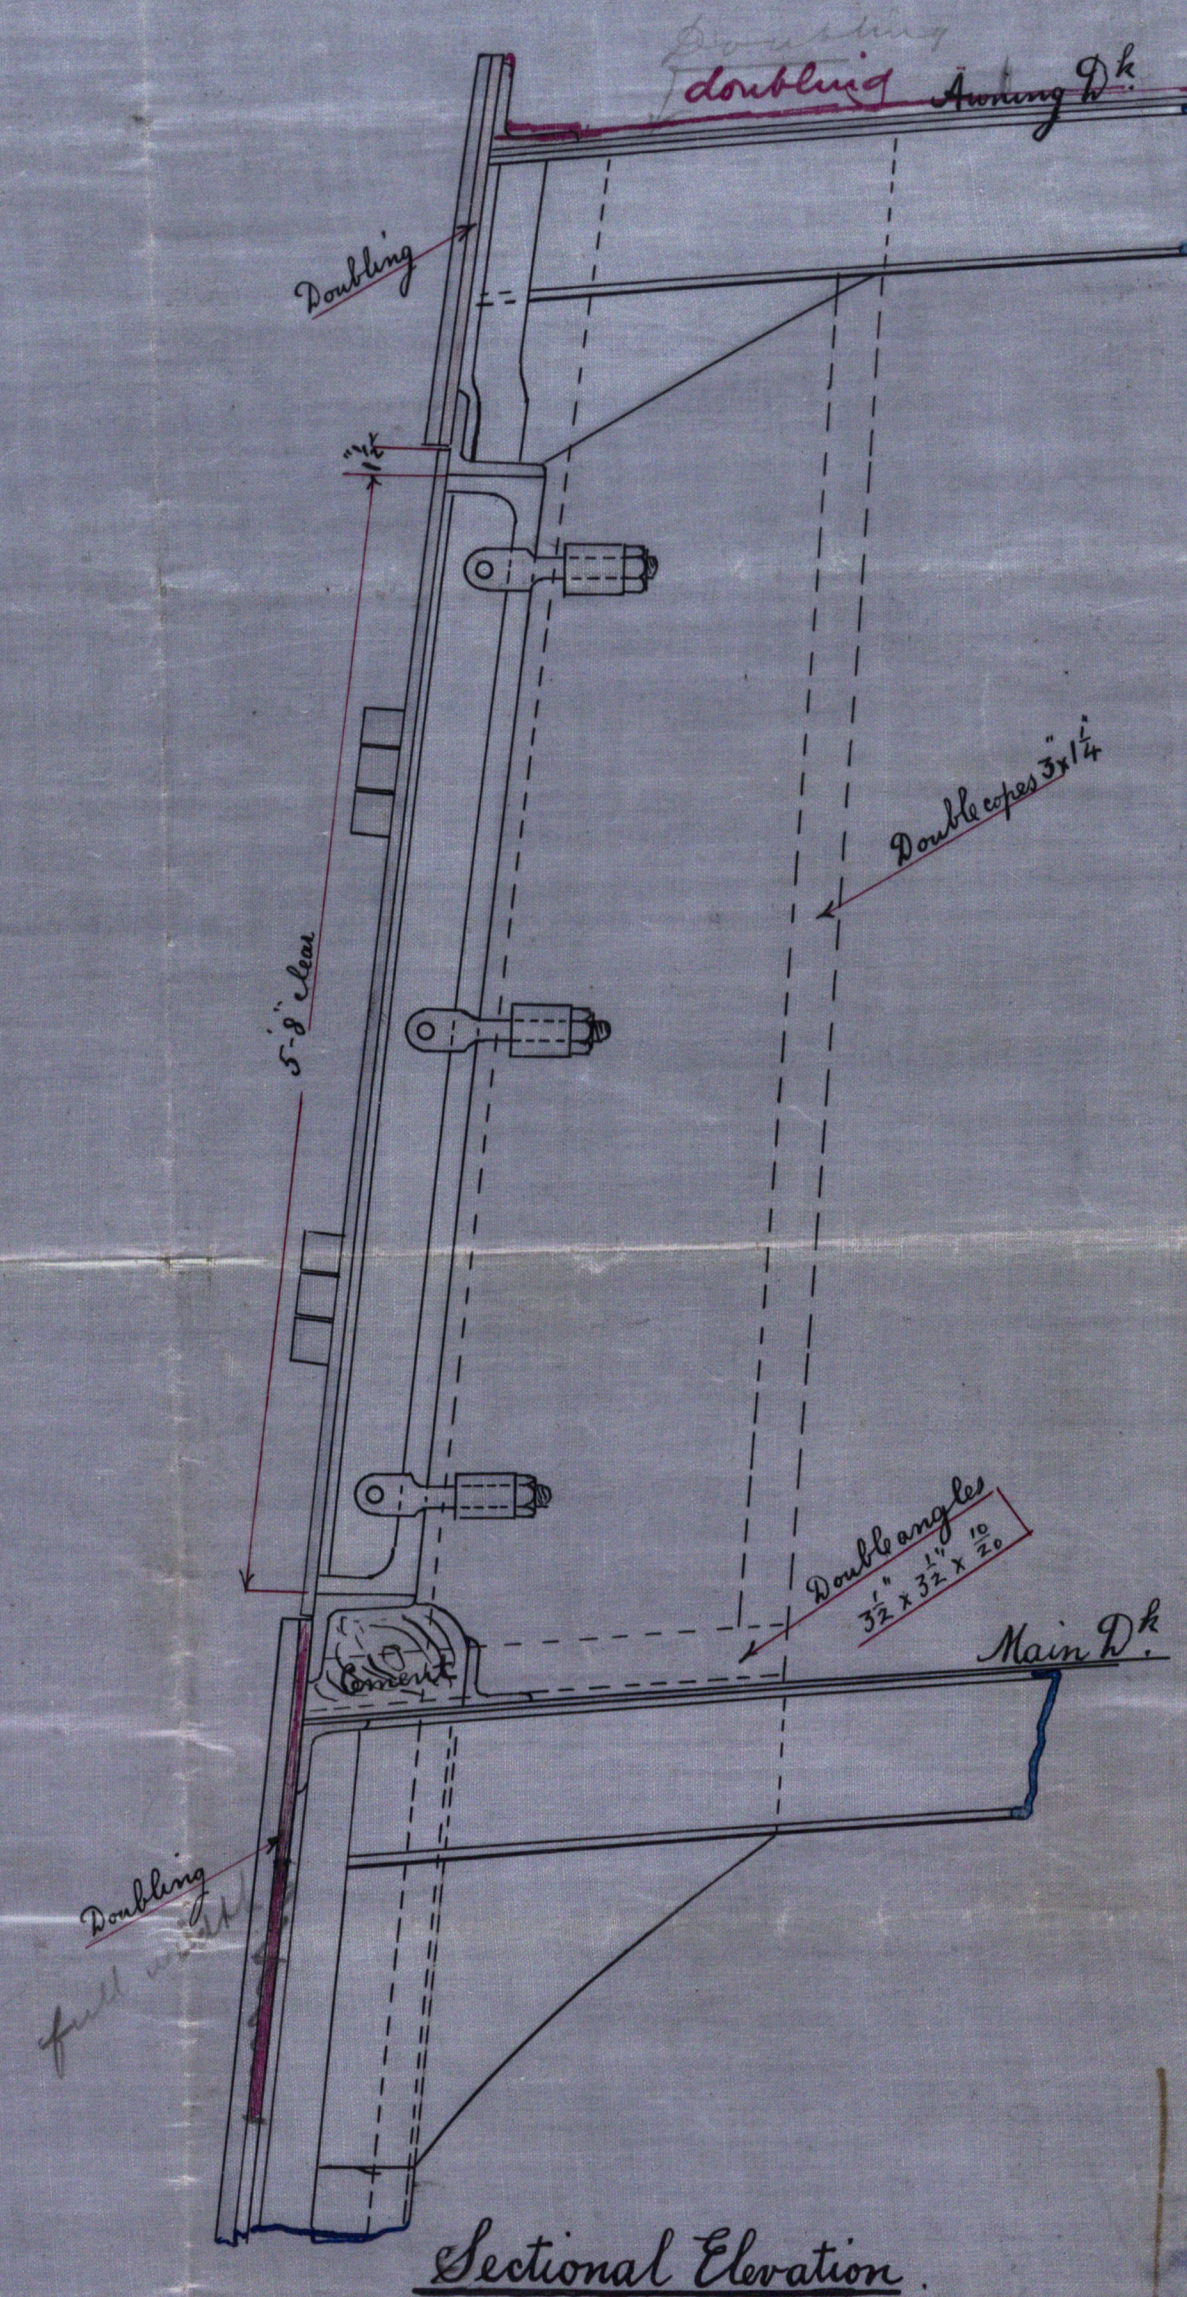



Gangway Doors No. 170 T.S.S.

Scale 1" = 1 foot.

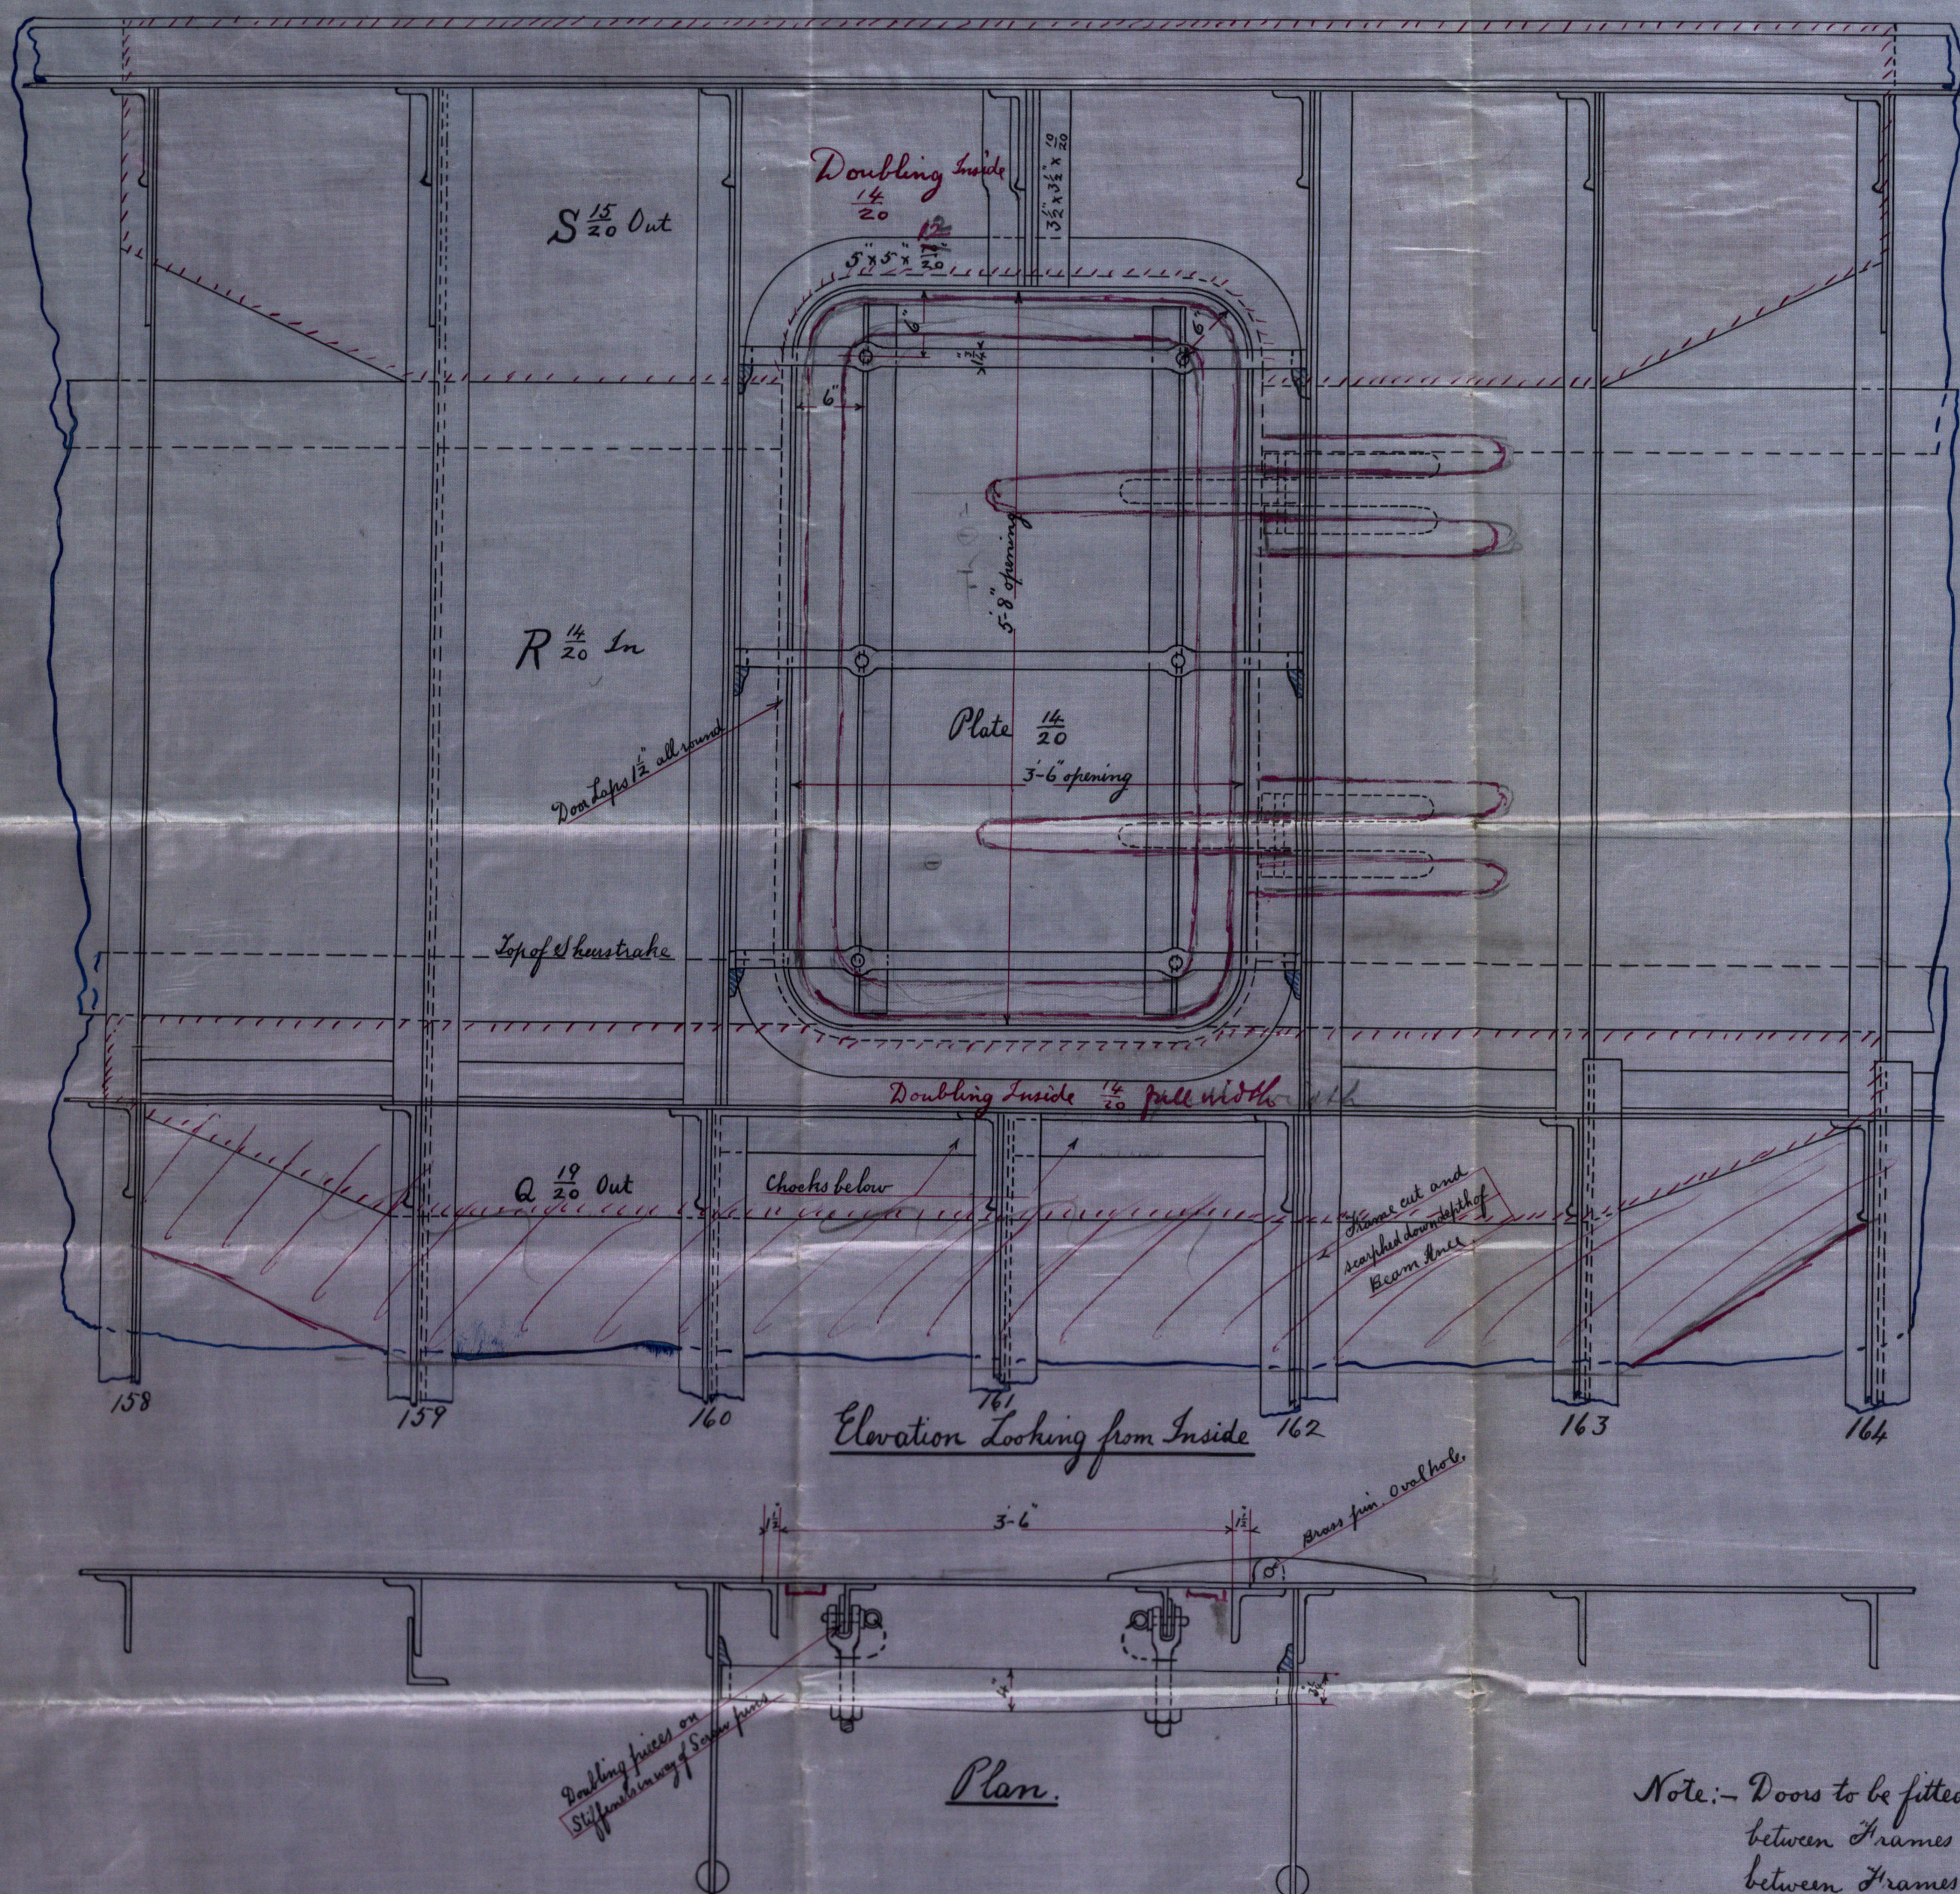

Note:- Doors to be fitted on each side of vessel
between Frames 30 & 32 Aft. and
between Frames 160 & 162 For'd.

13/200

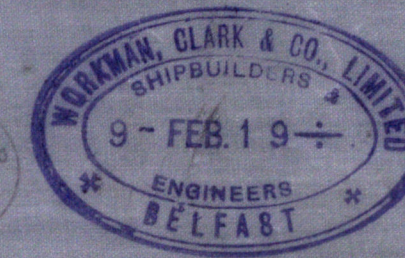[illegible]

Workman Clark & Co

S. S. No 170

Plan of Gangway Doors.

S. S. "INDIAN"

Report No 5212

critically examined



Elevation of Gangway from inside



© 2019

Foundation