

Workman Clark & Co. Ltd.

051.2.2.T

Sketch showing attachment of Quarter Girders to Bulkheads

Sketch showing attachment of Quarter Girders to Bulkheads


18.11.99

18.11.99

Nº 170 T.S.S.

Scale 1/4 = 1/100.

18.11.99

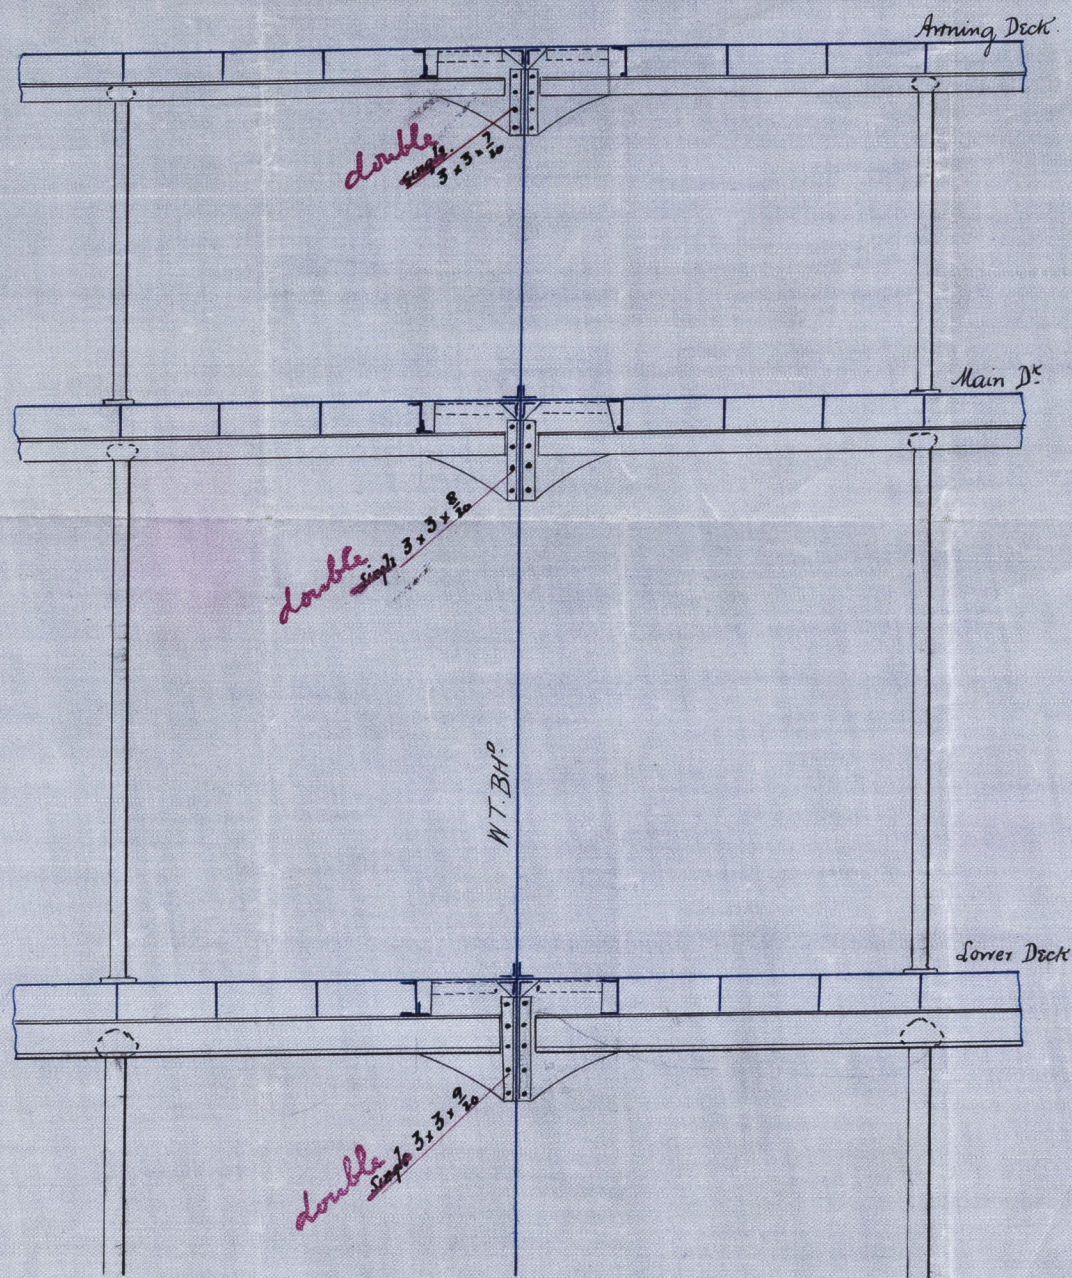

Elevation



Lloyd's Register  
Foundation

BEL71-075



Workman Clark & Co.

T.S.S. No. 170

Connection of quarter guides  
to Bulkheads.


S. S. INDIAN

Report No 5212

Attachment of Quarter Guides to Bulkheads

No 170 T.S.

Scale 1/4" = 1' 0"

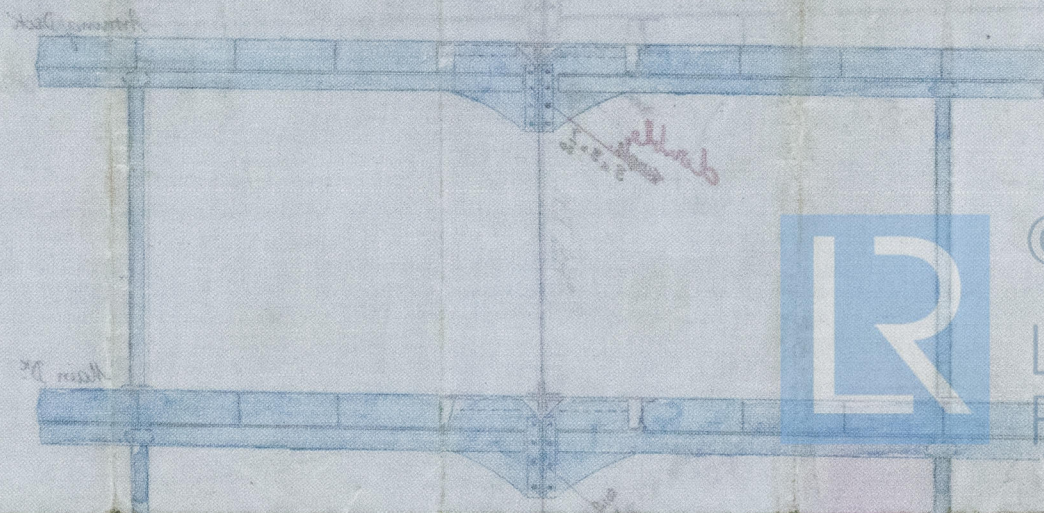

© 2019

Lloyd's Register  
Foundation