

28.4.99
4.10.99
27.10.99
18.11.99
2.12.99
13.2.00
8.5.00
17.5.00

No 170
Longitudinal Elevation T.S.D. 482'57" x 42'10" m²
— Scale 1/8 inch = 1 foot. —



17/4/99

RECEIVED
15 APR 1899
BELFAST
LLOYD'S REGISTER OF SHIPPING
15 APR 1899
BELFAST


Delfart
Workman Clark H.
S.S. 482nd (2nd)

Profile

H. 140

S.S. Indian

REPORT NO 5212

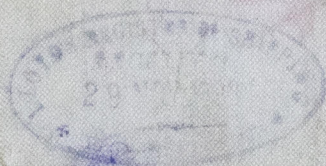

© 2019

Lloyd's Register
Foundation