

RLB. 5/3/00.

WORKING PRESSURE **206** LBS. PER SQ. INCH.

TEST // 412 a b c d


MAIN BOILER T. S. S. "PARIS".
SCALE 1"=1 FOOT. 6 OFF.



Belfast
Amended Plans
Double Ended Boilers

L.S.S. Paris


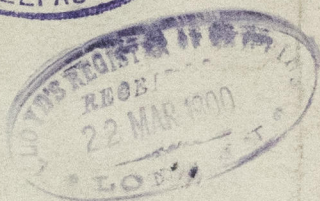

17



© 2019

Lloyd's Register
Foundation

BEL71-098