
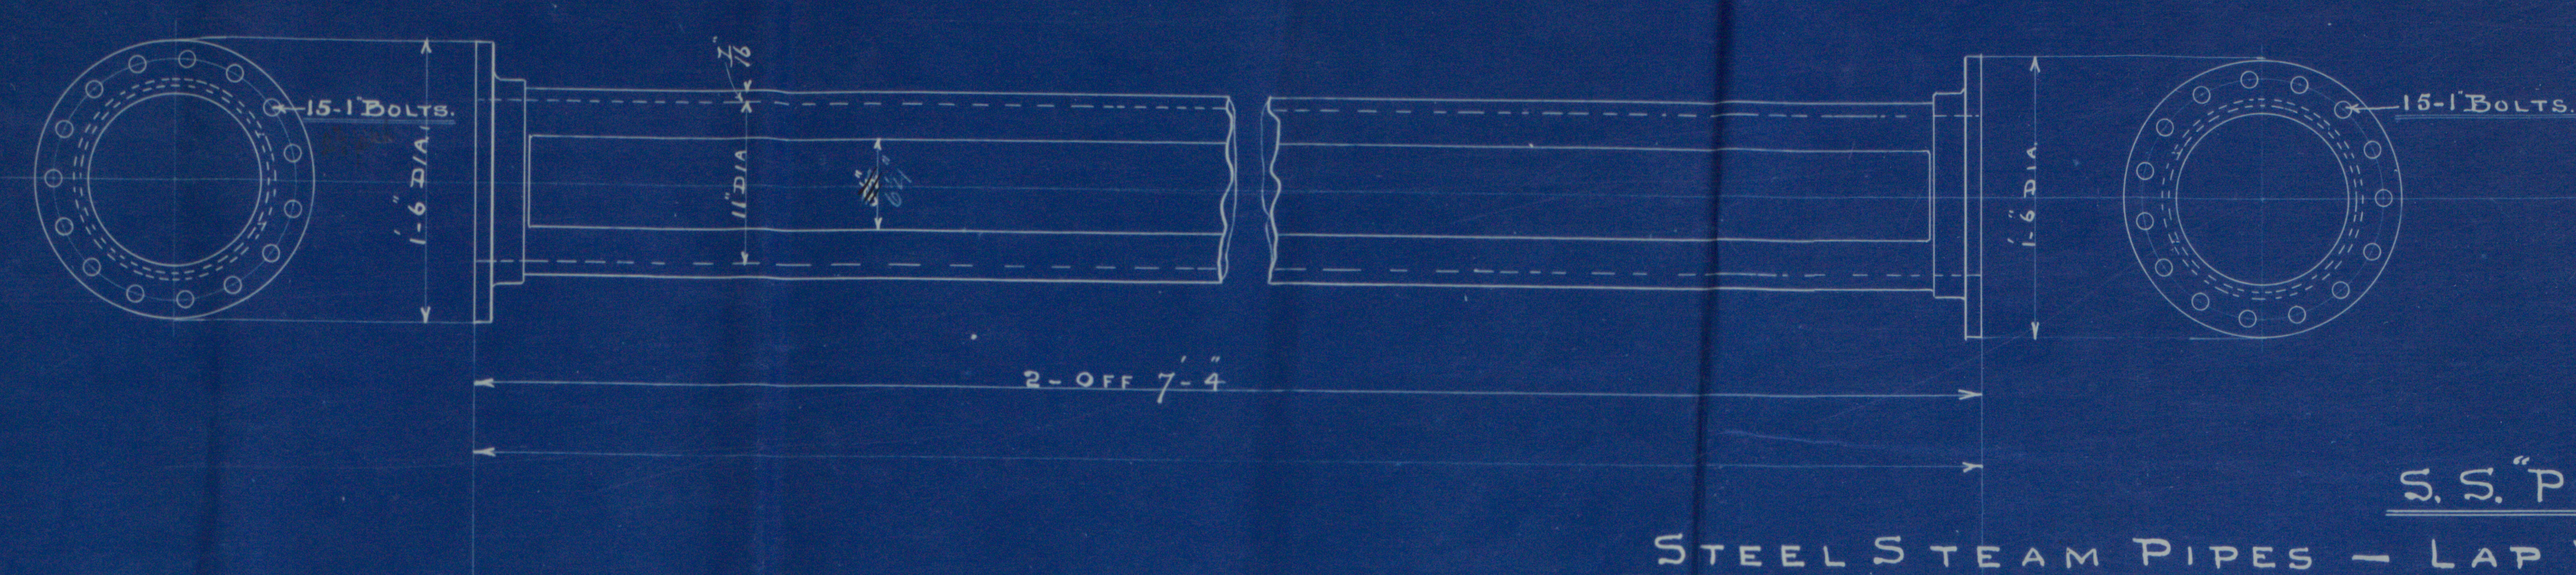


31/1/18

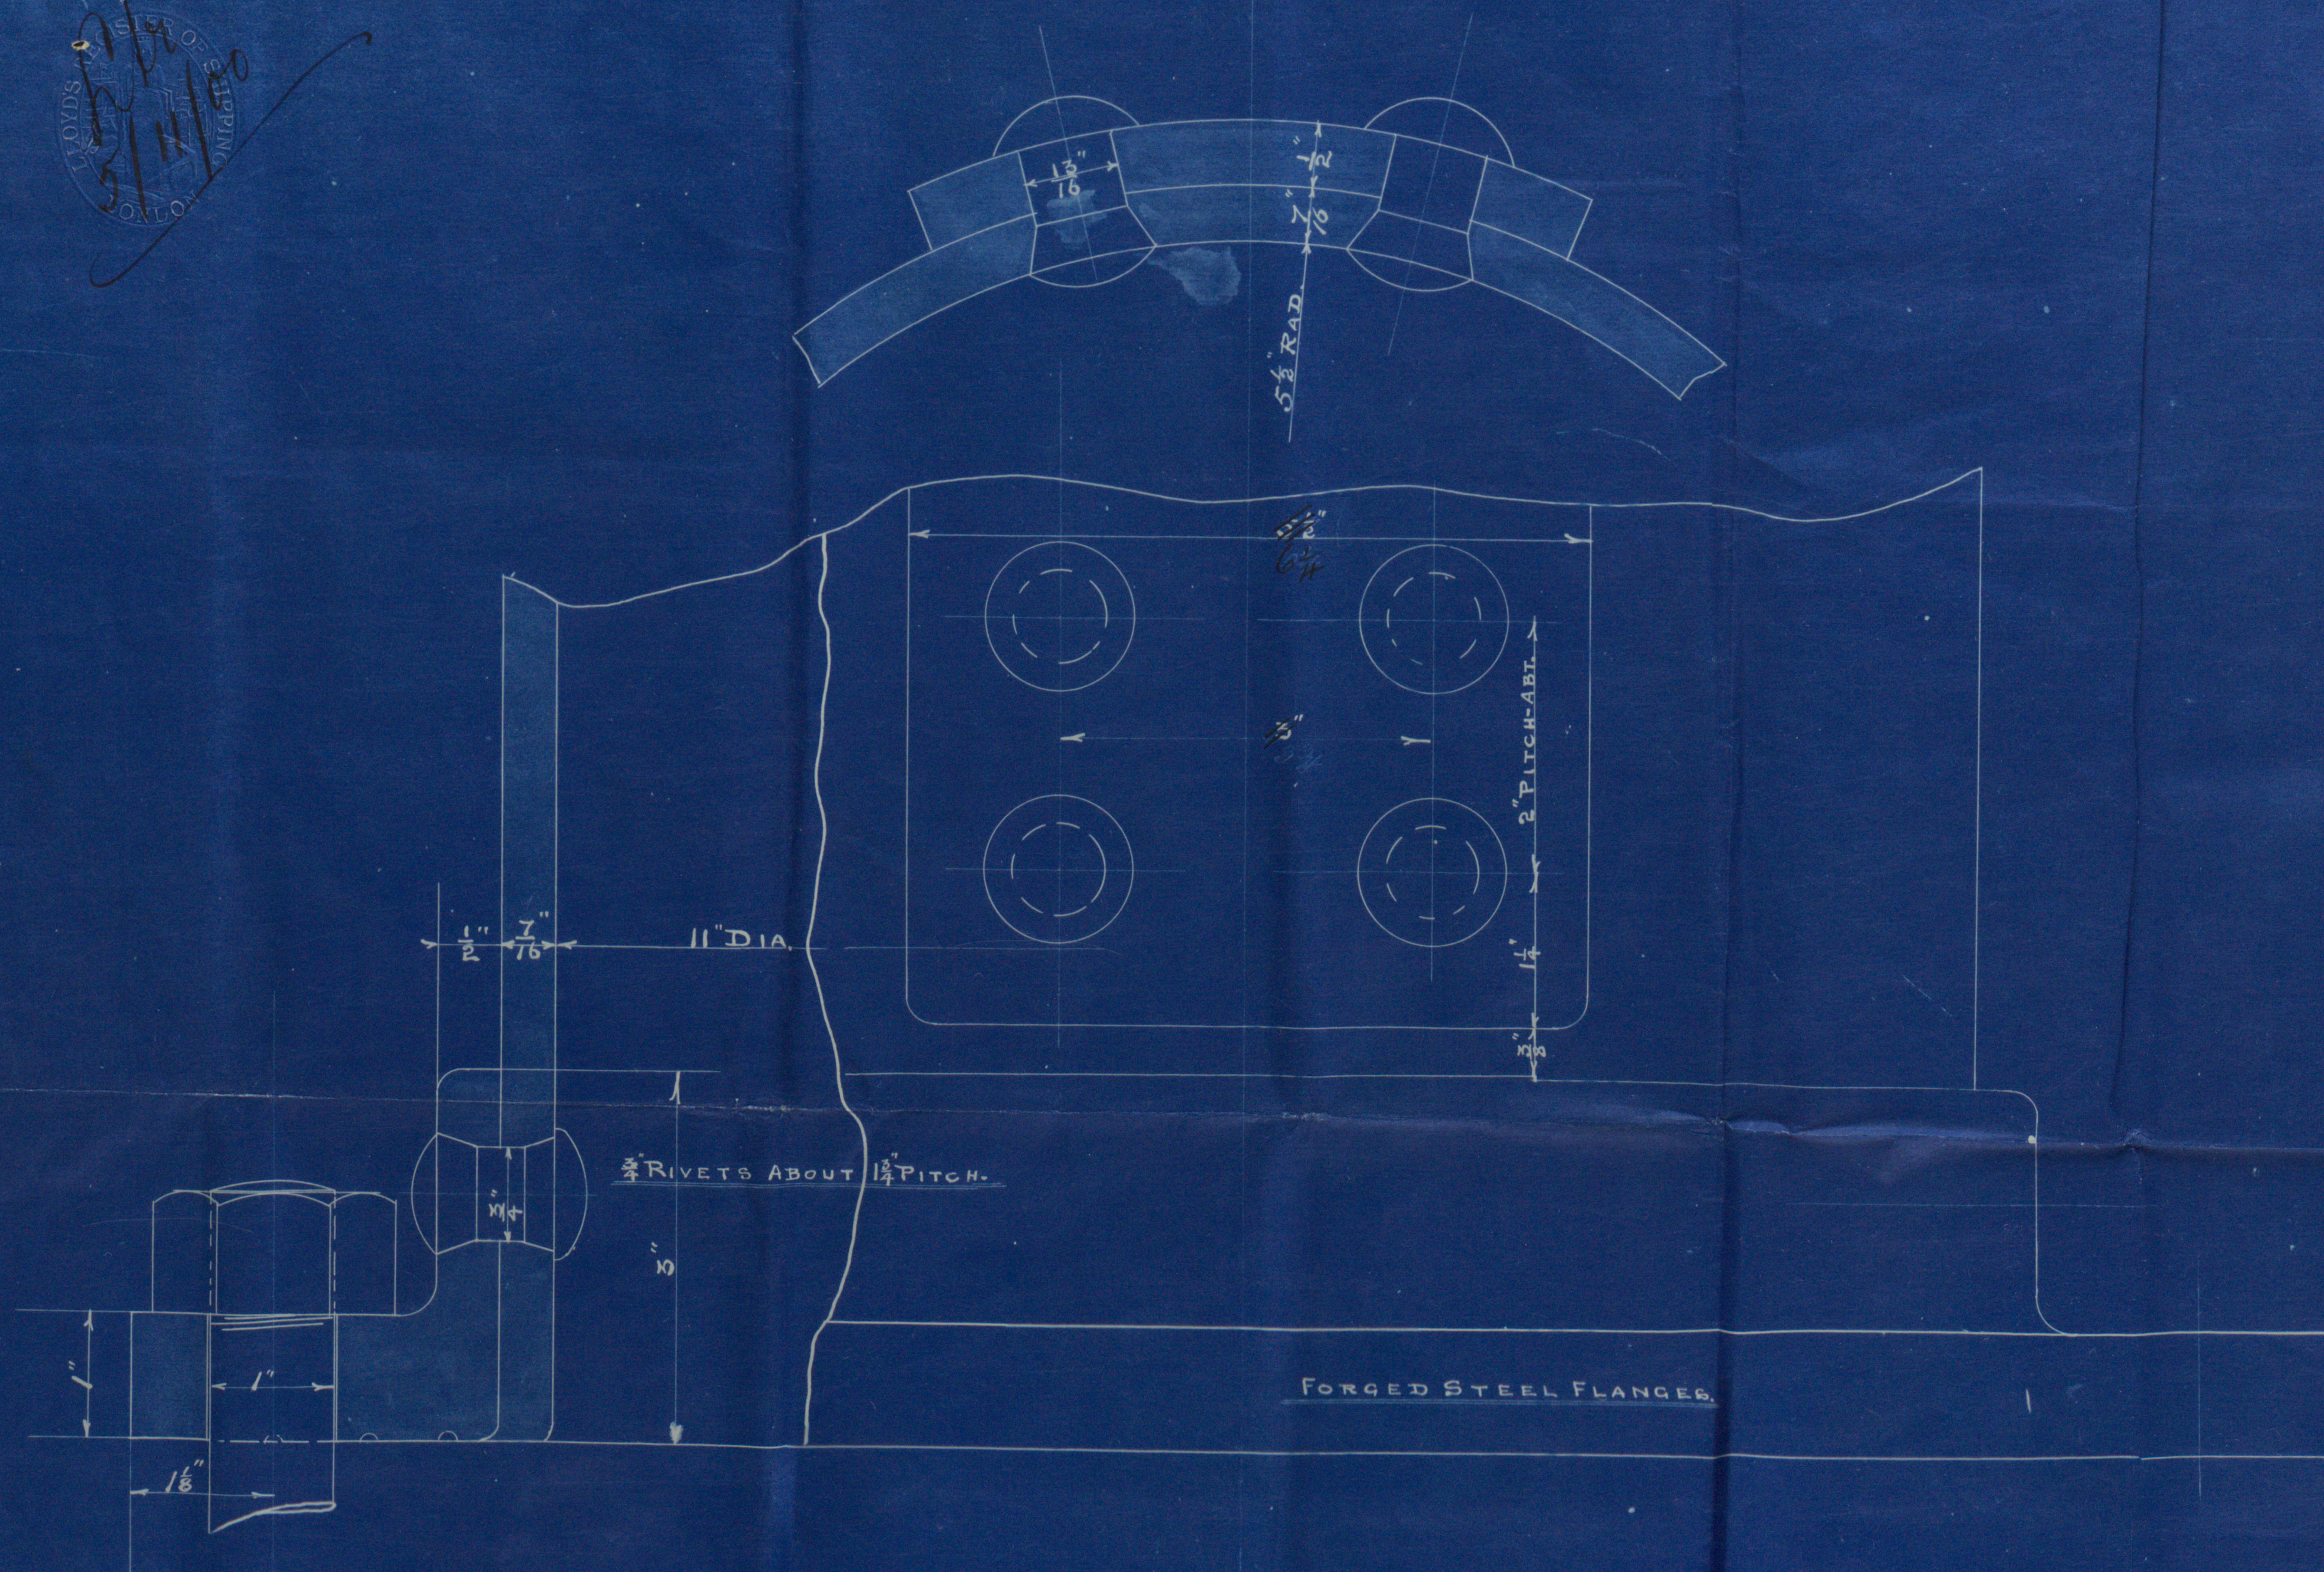



S.S. "PHILADELPHIA".

STEEL STEAM PIPES — LAP WELDED WITH BUTT STRAP.

WORKING PRESSURE 206 LBS. PER SQ. INCH — TEST PRESSURE 618 LBS. PER SQ. INCH.

UNDER SURVEY OF BOARD OF TRADE, & LLOYD'S

ALL FLANGES TO BE FACED, TURNED ON EDGE & DRILLED, TEMPLATES SUPPLIED BY H&W.

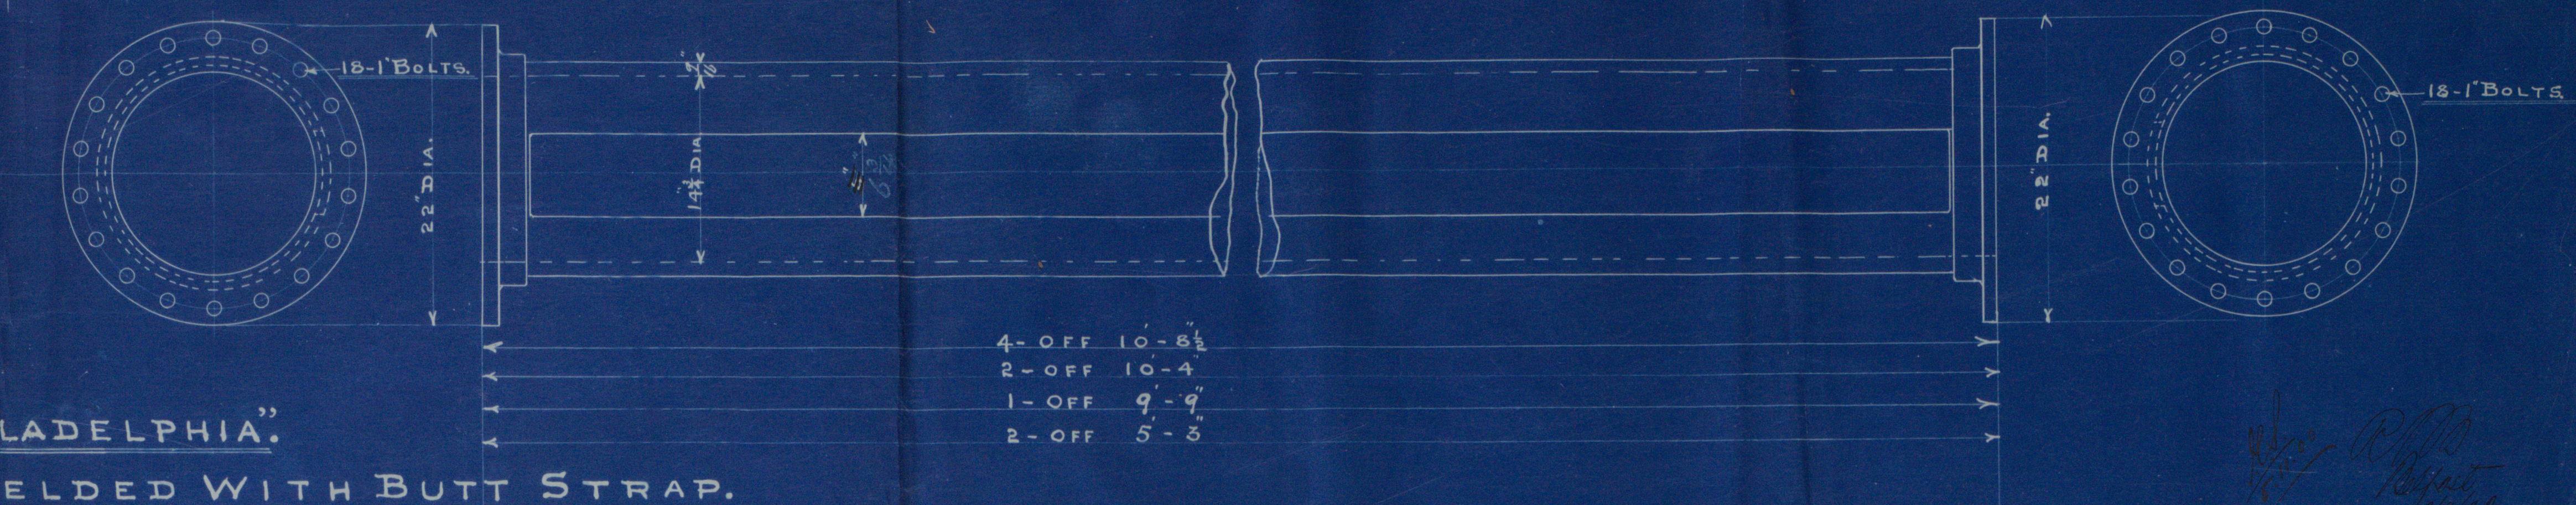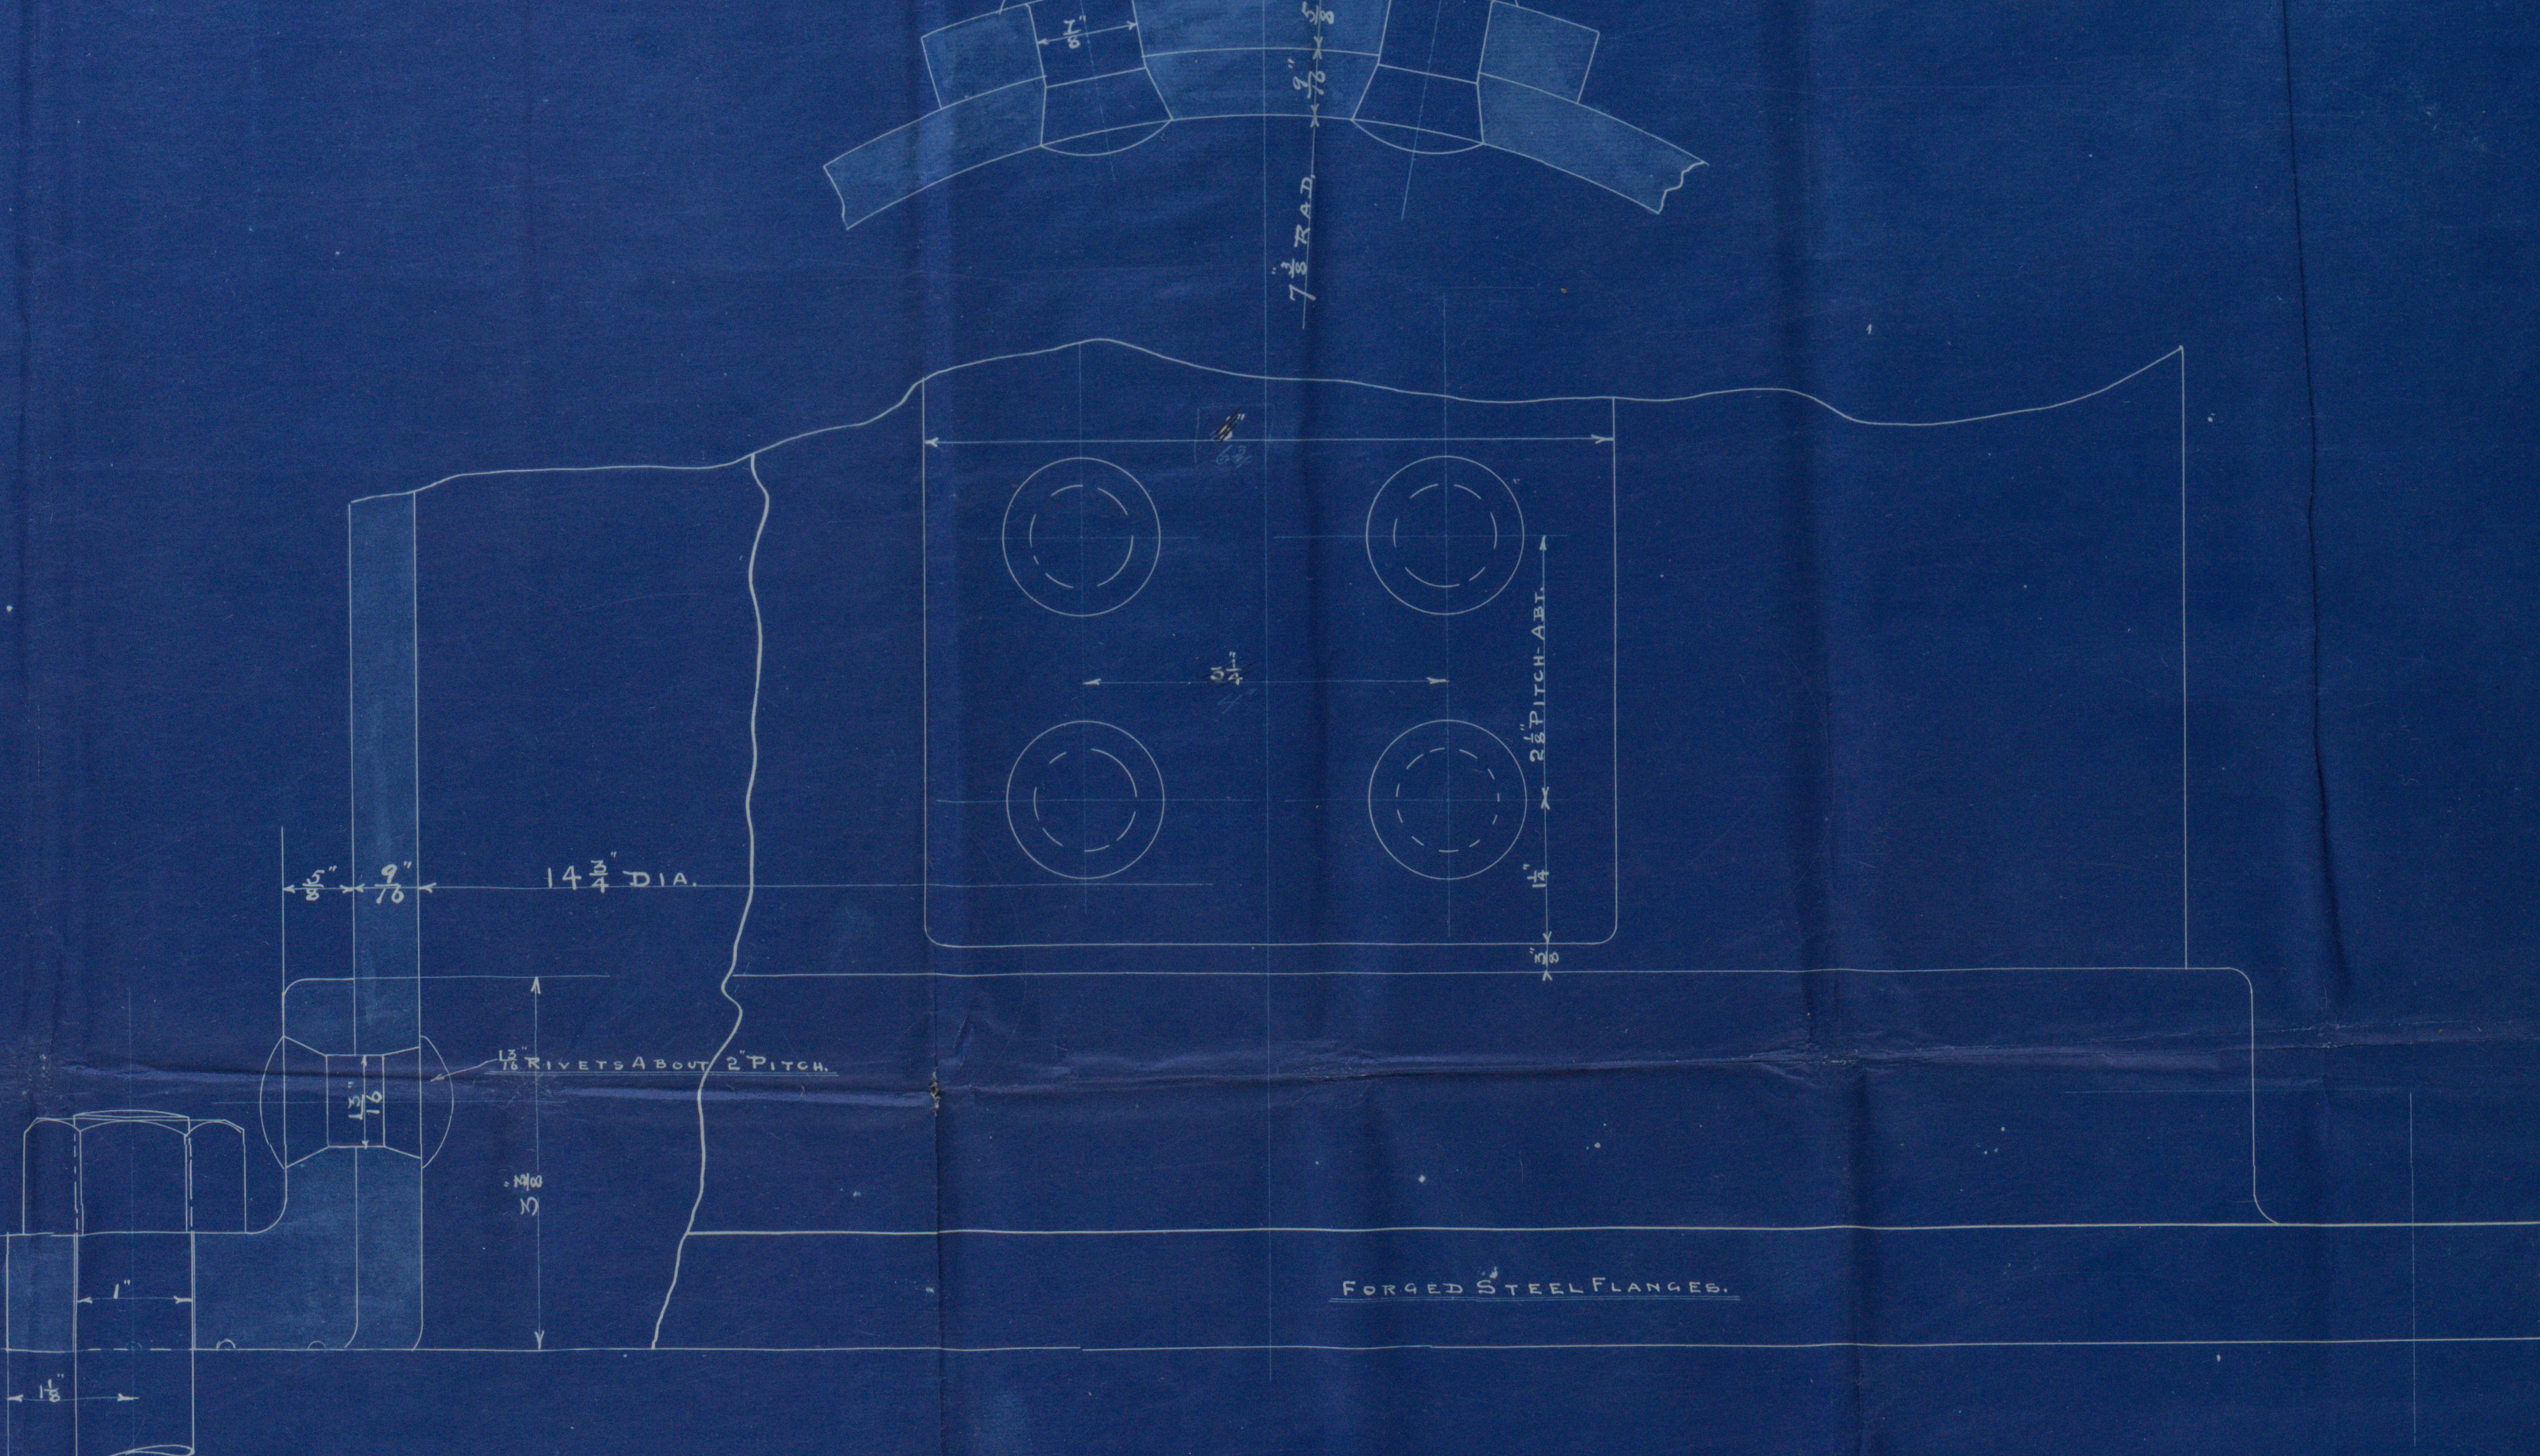

- 4 - OFF 10-8 1/2
- 2 - OFF 10-4
- 1 - OFF 9-9
- 2 - OFF 5-3

PIPES MADE BY A & J. STEWART & CLYDESDALE LTD. GLASGOW.

These pipes tested to 620 lbs. sq. inch
H.S. 10/1/18

00-12798

Belfast
S.S. Philadelphia ex Paris
Main steam pipes



© 2019

Lloyd's Register