
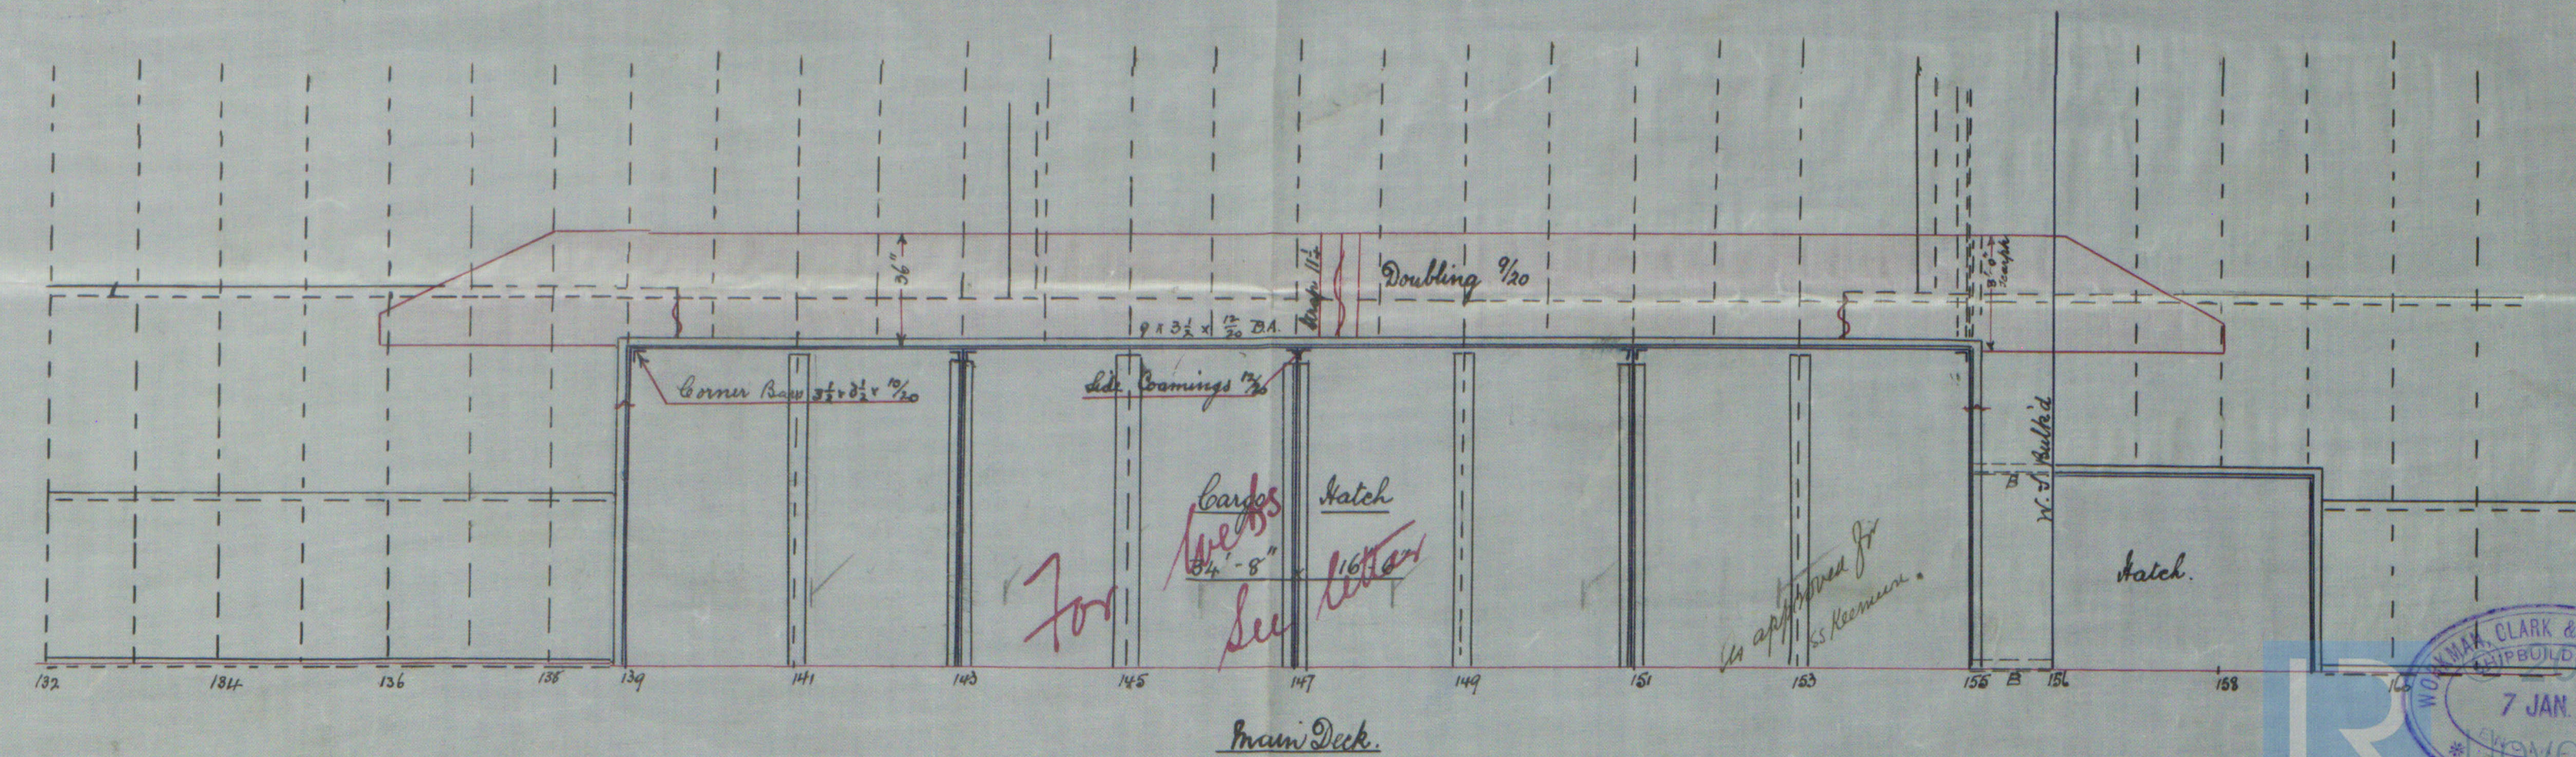
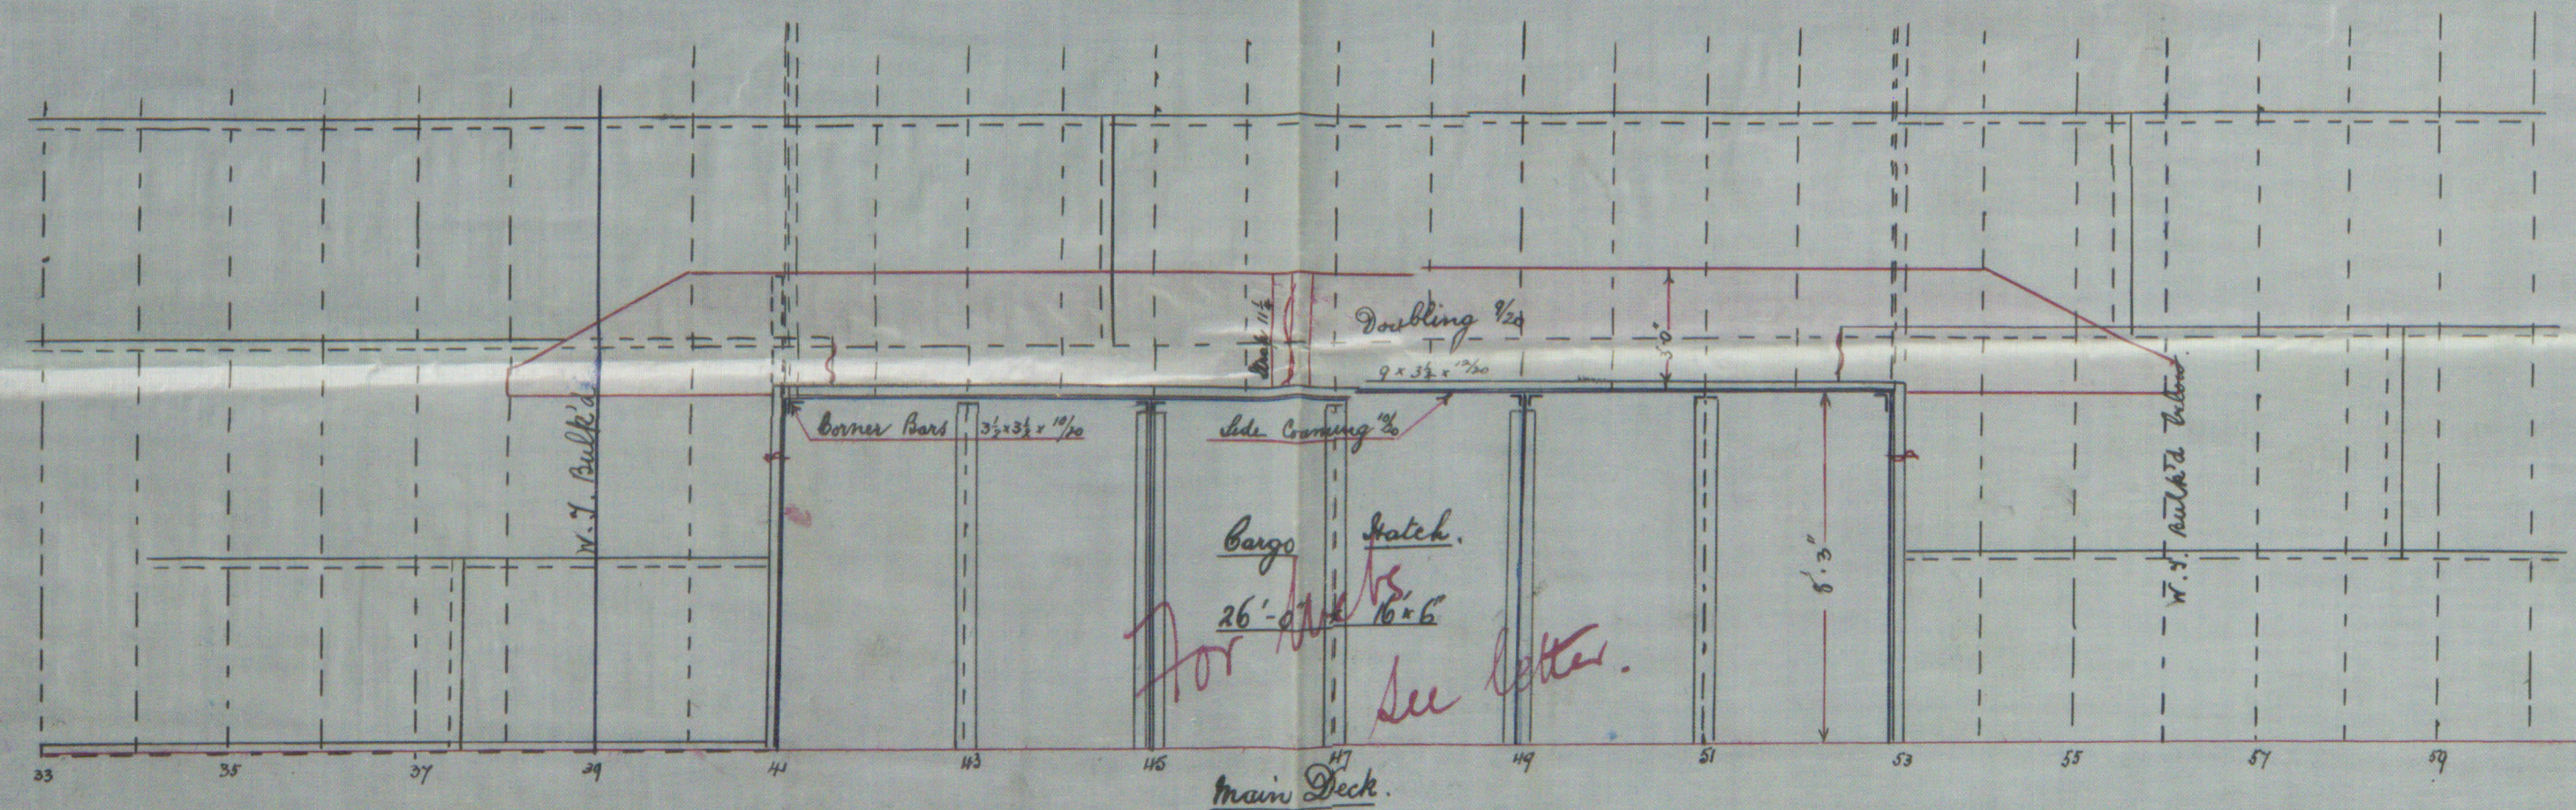
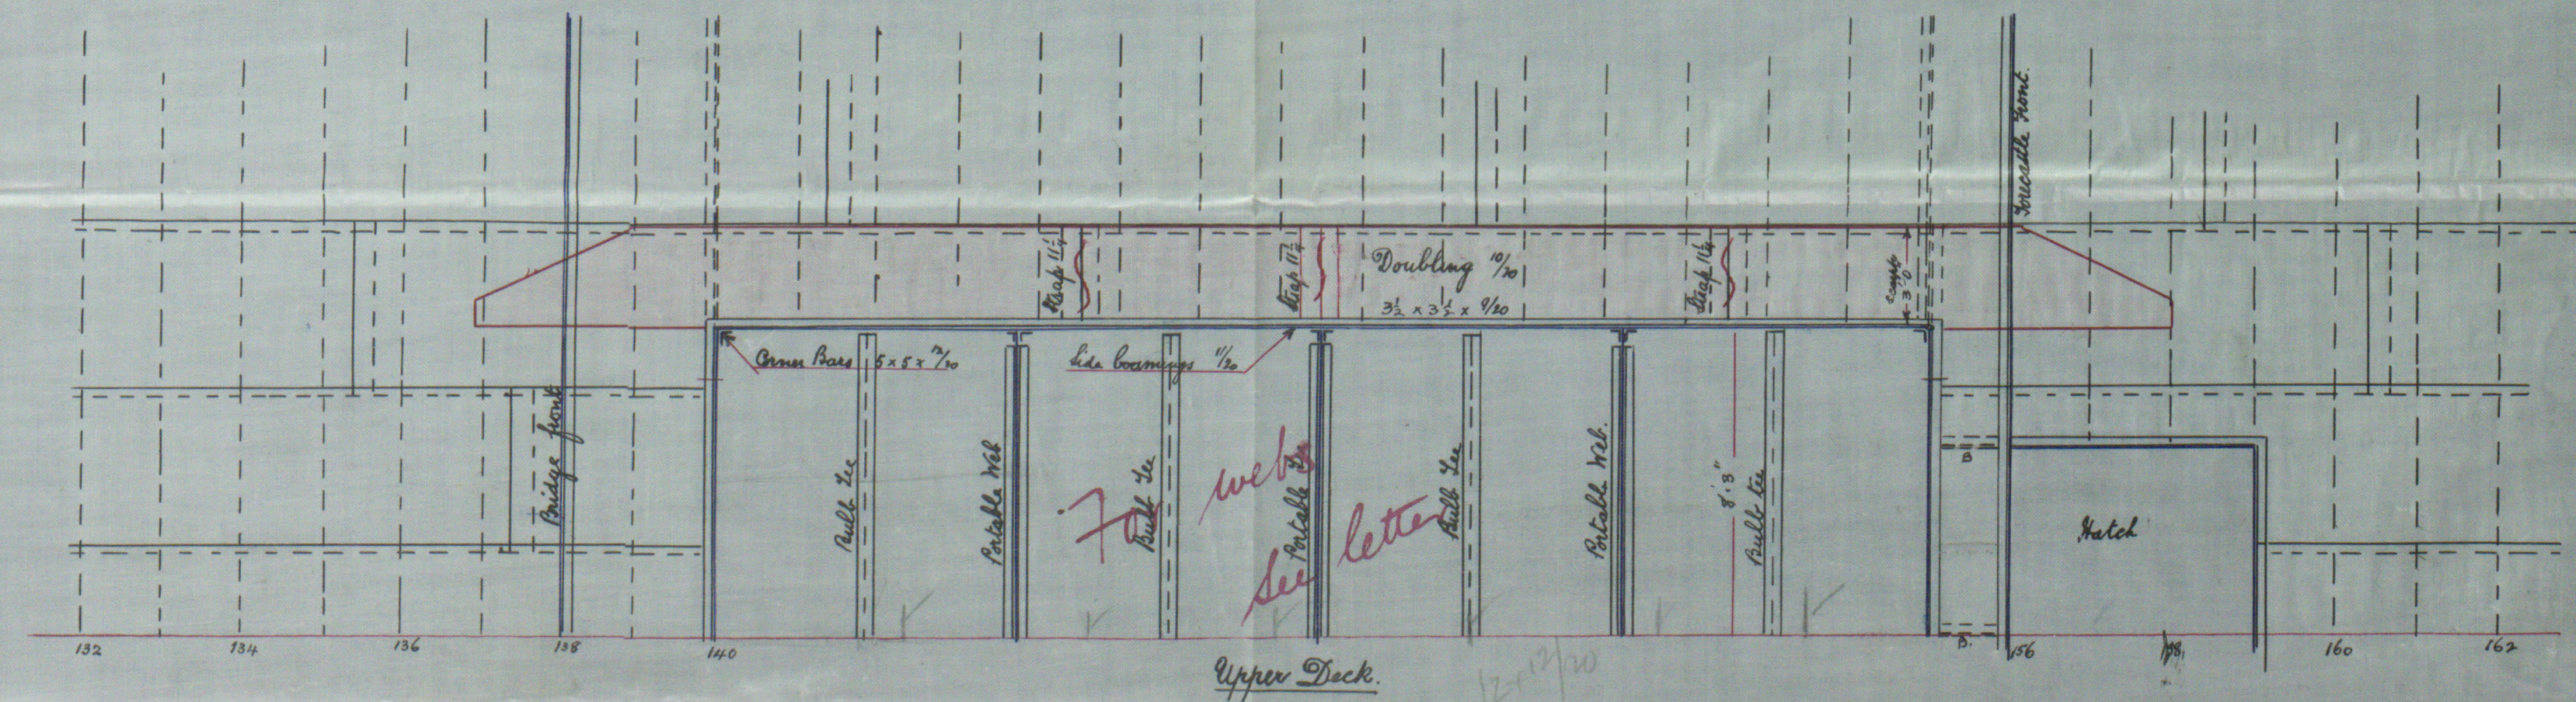


S. S. "Maplemore."
Plan of Decks in way of alterations.
Scale $\frac{1}{4}$ " = 1 foot.

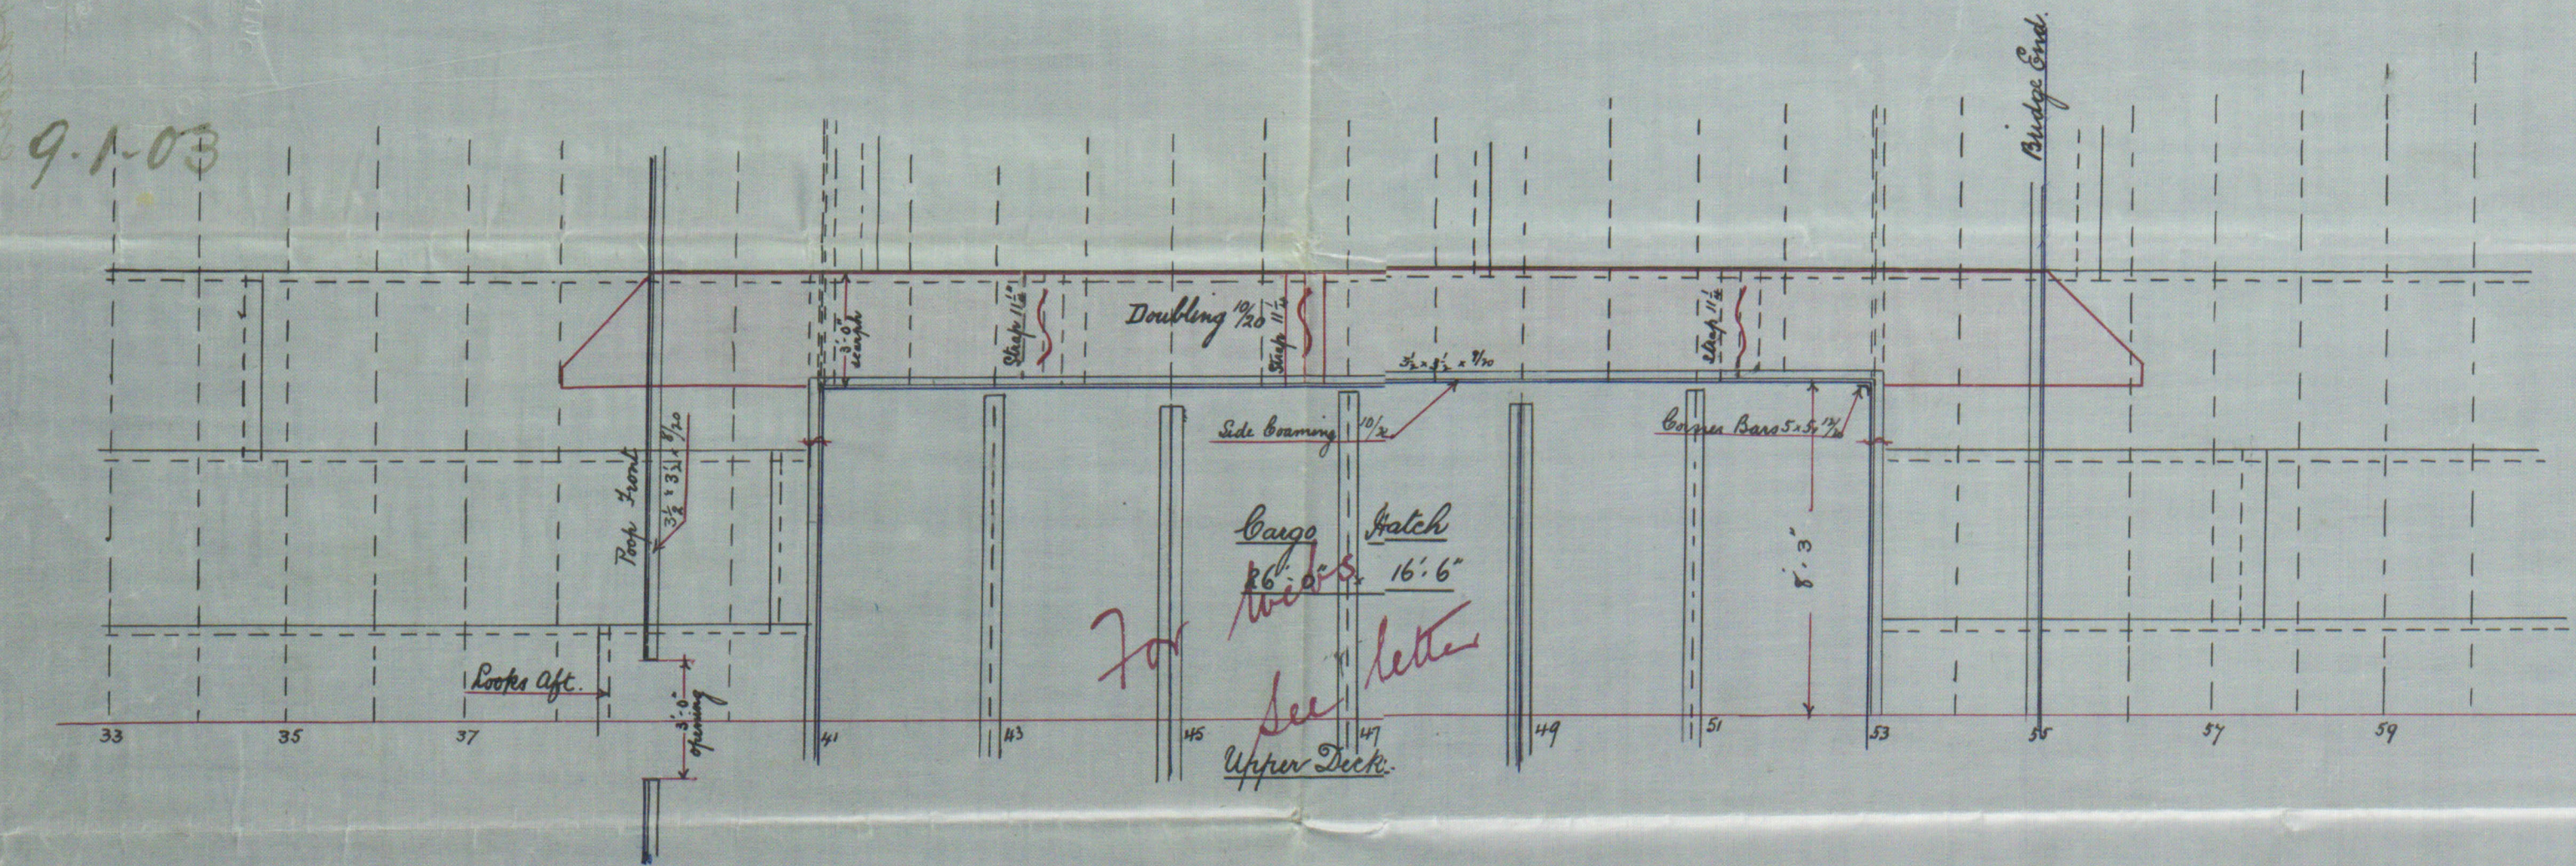

S.S. Maplemore.

Plan of decks in
way of alterations

© 2019

Lloyd's Register
Foundation