

L.S. GARDNER
 Surveyor
 L.S. GARDNER

9.1.03

Material				
Doubblings				
2	SD	15-5	38 1/2	18 1/20
2	2	15-4	"	"
2	3	14-6	"	"
6	DS	1-10 1/2	39	22 1/20
2	"	"	42	"
2	"	"	31	"
2	BG	16-4	55	8 1/20 Gangway Doors
2	OS	26-0	4 x 3 1/2 x 19 1/20	Door frame

Steps 3rd
 Steps 4th


Both walls

S.S. Maplemore


Plan showing Sheet & Doublings etc in No 4 Well

Scale 1/4" = 1 foot

NOTE: ON 149 WEB & FACE BARS ARE INTERCOSTAL
 OTHERWISE TO BE SIMILAR TO WEB ON 139

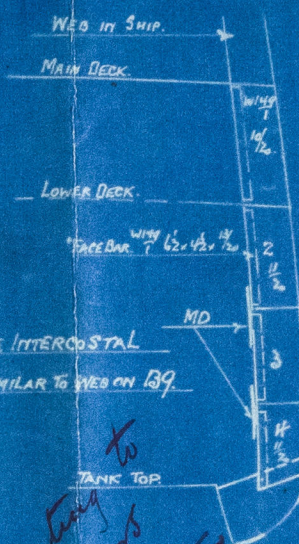

MATERIAL FOR WEB ON 149				
2	W149	7-10	22 1/2	10 1/20 Below Main & Lower Decks
2	2	6-6	"	1 1/2 " Lower 11k & Upper Stringer
3	5-6	"	"	" Upper Stringer & Lower "
4	3-6	24	"	Below Lower Stringer
Diamond Plates				
4	MD	12	12	8"
Angles				
2	W149	22-6	6 1/2 x 4 1/2 x 1 1/20	Face bar
1	2	20-0	3 1/2 x 3 1/2 x 1 1/20	Lugs

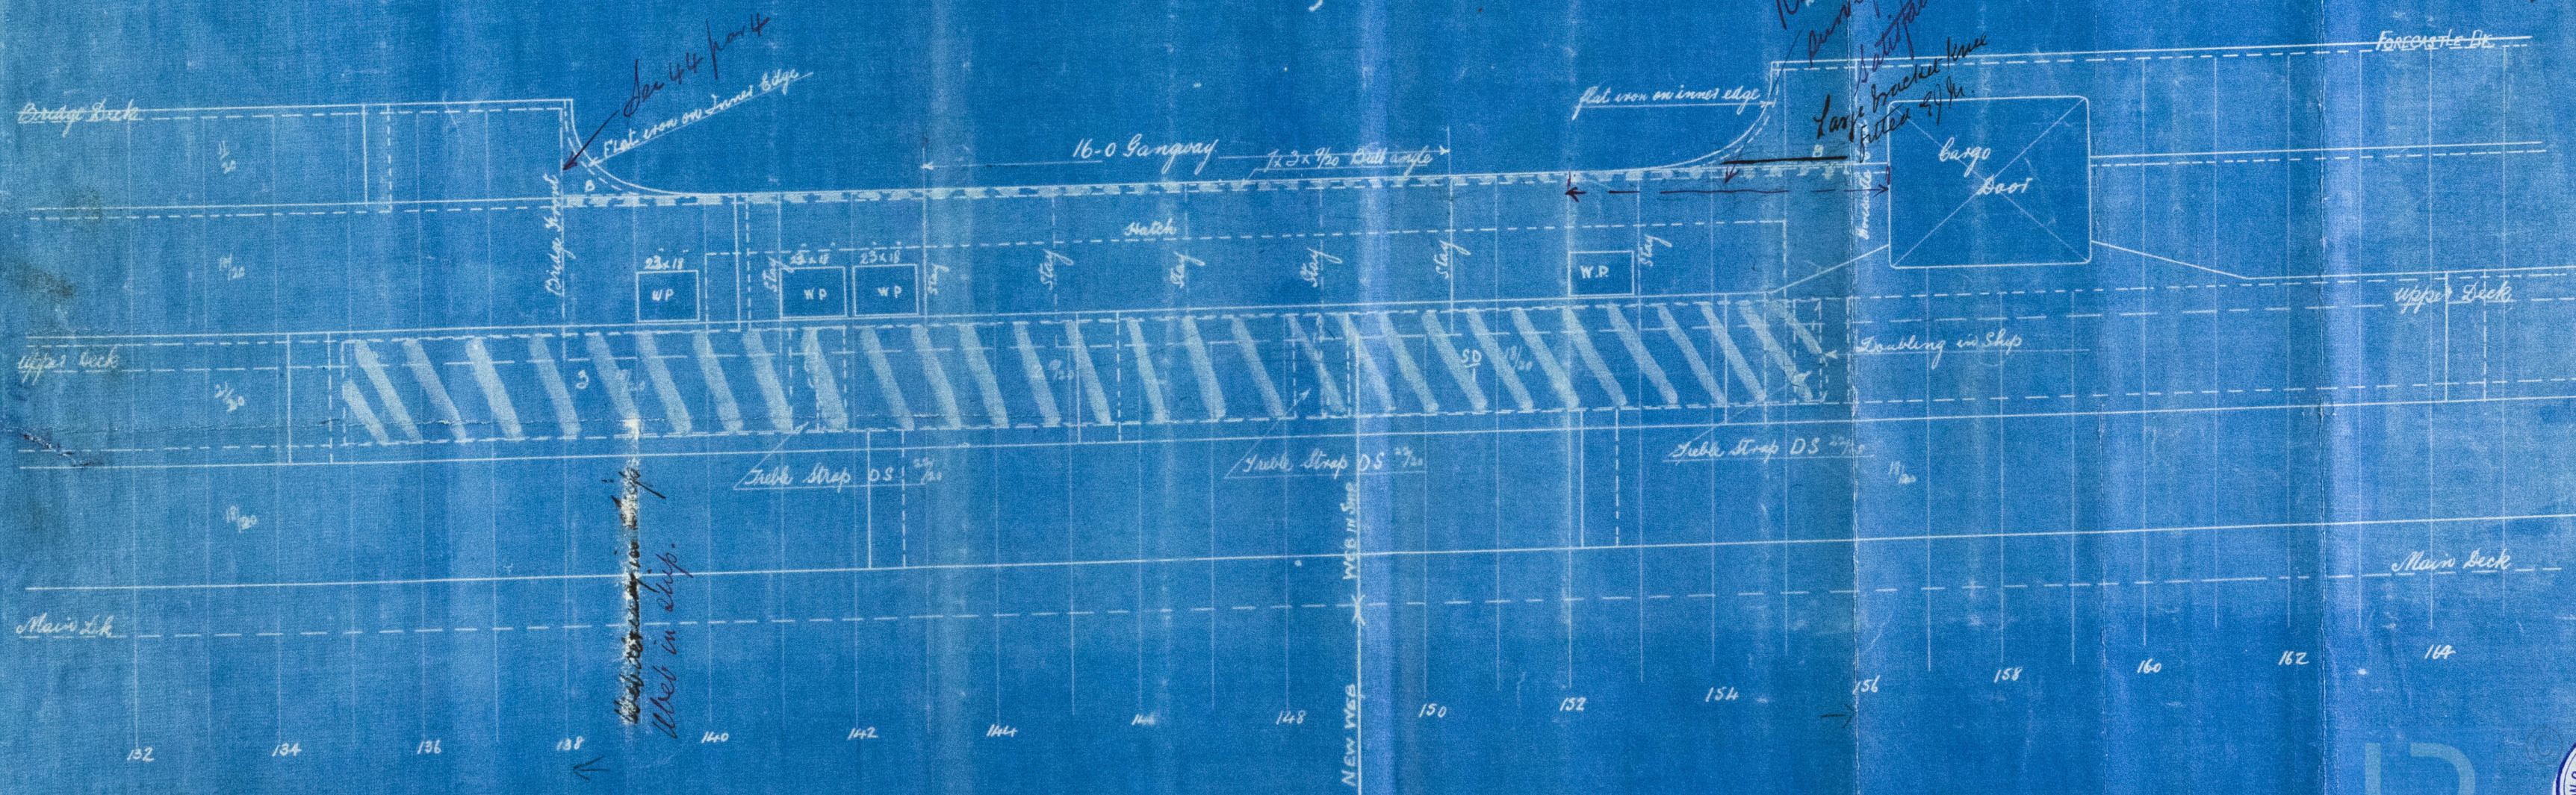

Web in ship
 Web in ship

Reverted to
 previous
 satisfaction
 Large bracket line
 fitted 3/4"



BE172-0019

ss Maplemore

Plan of alterations
in forward well



© 2019

Lloyd's Register
Foundation