TOTAL HEATING SURFACE 2001 ☐'
" GRATE SURFACE ~~63~~ 61·6 ☐'

6698

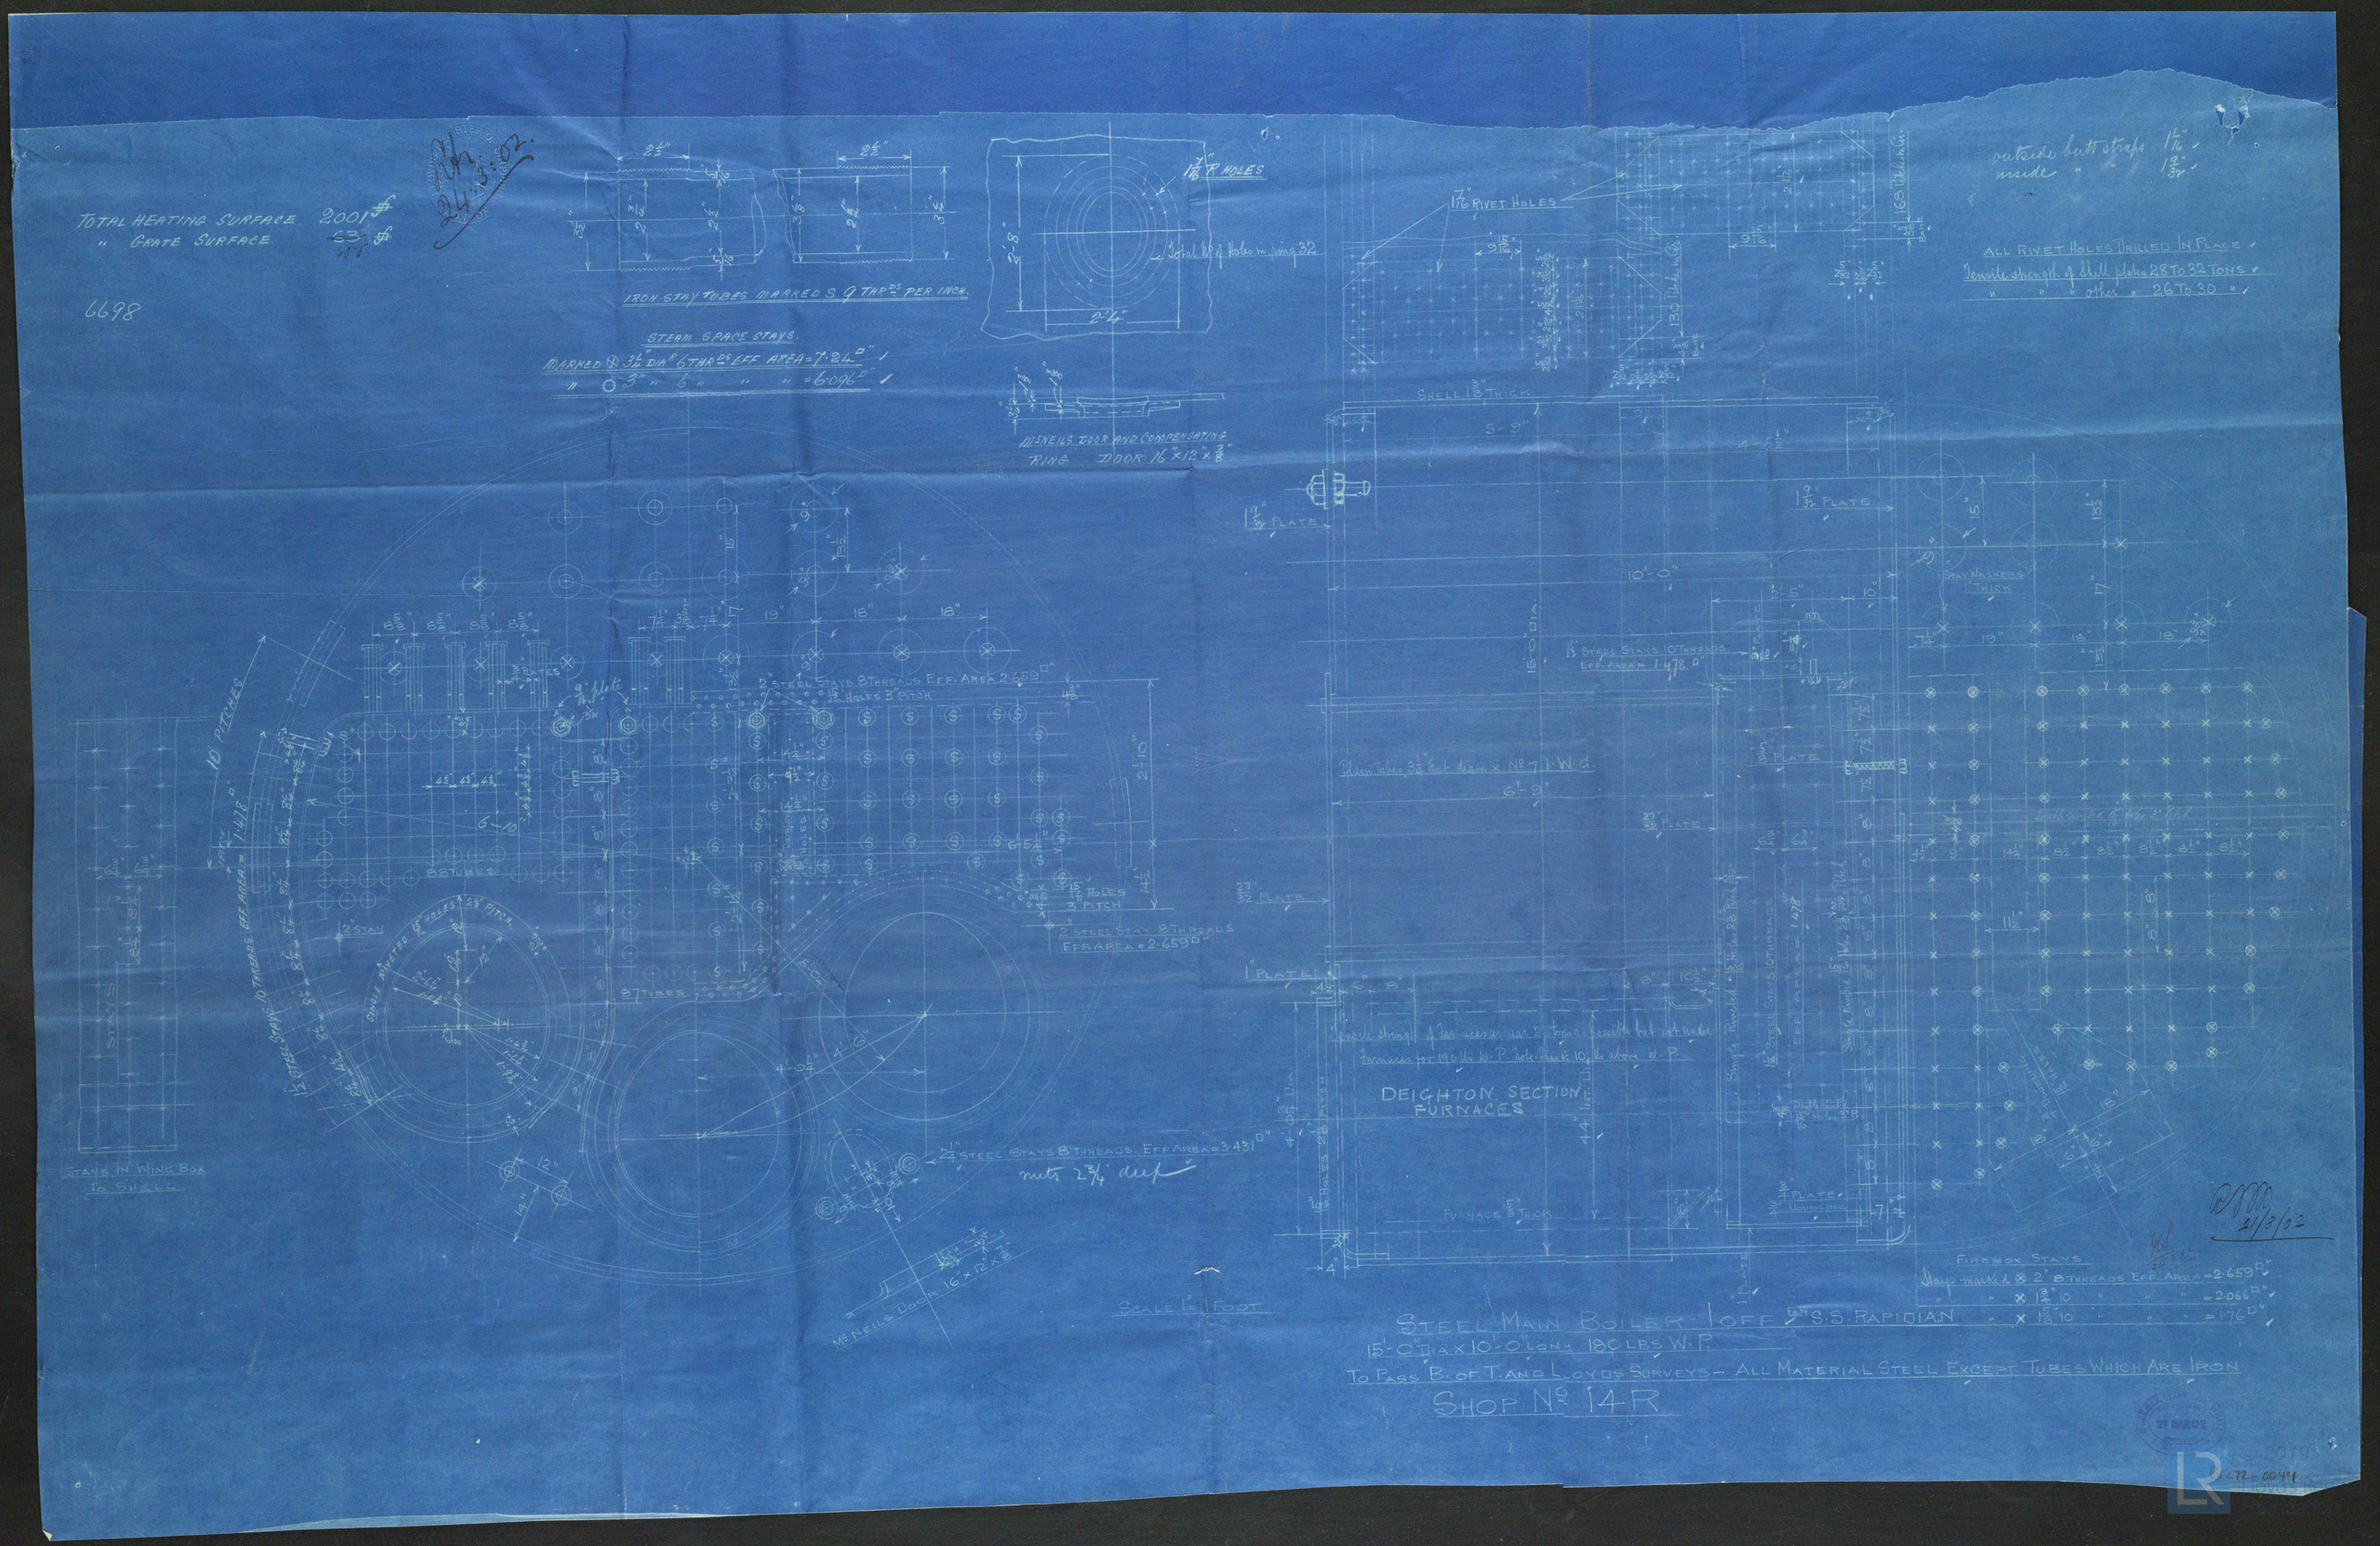

Belfast

Workman Clark & Co

14, R

P.S. "~~Rapidan~~" "Nau"

"Taversham Grange"

LLOYD'S REGISTER OF SHIPPING
RECEIVED
24 MAR. 1902
LONDON

© 2019
Lloyd's Register Foundation