Lr. t. Bgn.
29/6/83.

Sketch showing Arrangement of Keelsons & Floors in Engine Room.

S.S. No 8.

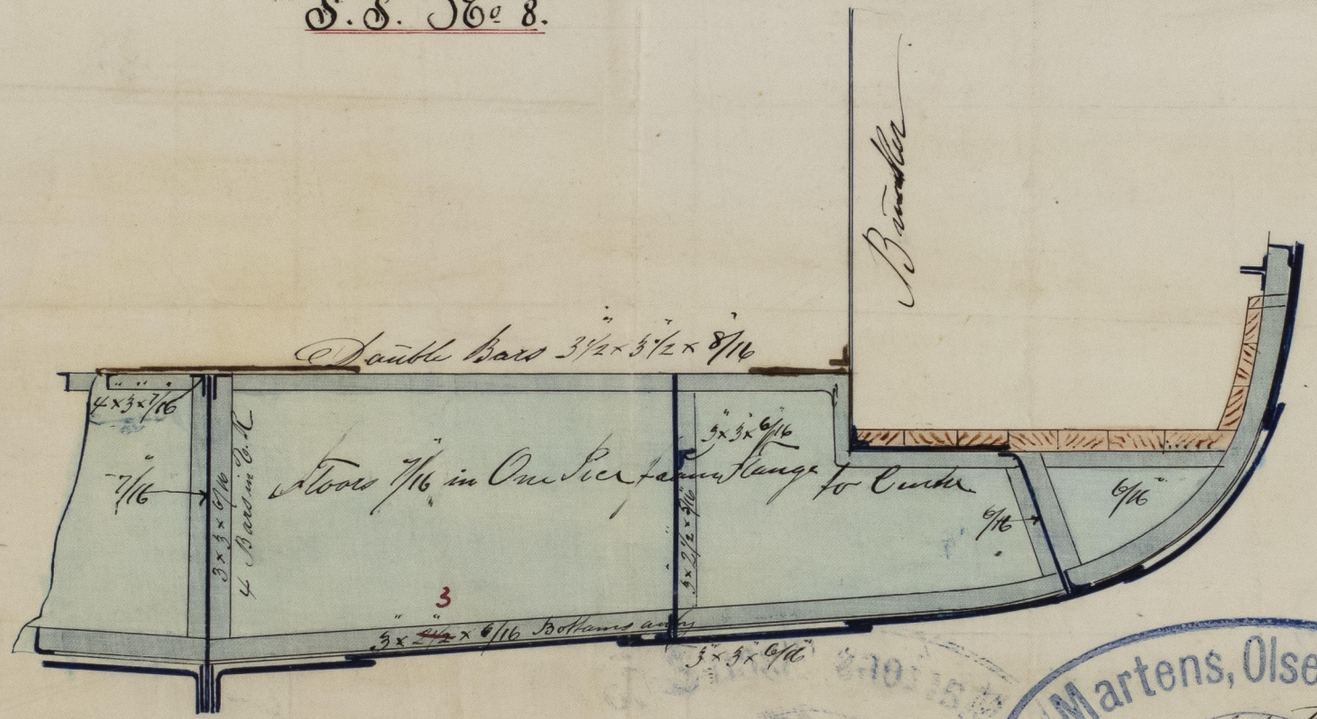

Scale ½" = one Foot.

F. G. Hansen
Surveyor to Lloyd's

Martens, Olsen & Co
April 5th 83
Laxevaag
Copi 42
BERGEN.

© 2021 Lloyd's Register Foundation