

Lloyd's Register of British and Foreign Shipping.

(Received in the London Office)

P.


No. 280 Report on Ship Forgings.



Sir,

I beg leave to report that the undermentioned Forgings manufactured by Martens, Olsen & Co. of Larvaag, Bergen for the vessel No. 8, being built by Martens, Olsen & Co. of Larvaag, Bergen have been inspected by me in course of being forged and smithed, and found to be, so far as can be seen, satisfactorily forged and welded of good scrap iron.

Mark on Forging.

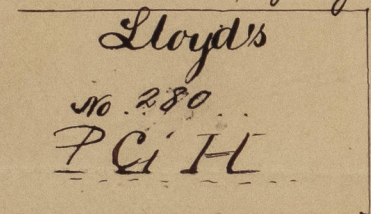


I am, Sir,

Your obedient, Servant

R. G. Hall V M B

The Secretary,
London.

	Stern Frames.	Rudder Frames.	Stems.
Material *	Scrap iron		Scrap iron
How made	Forged under steamhammer and welded of smith	Not made	but. stem 7 1/2 x 2 1/2 6 3/4 x 2 1/2
Dimensions	6 3/4" x 4 1/4"		
Progers on Inspection	Forging Welding Boiling		Forging Boiling Laying
Dates when Inspected	24/5. 22/5. 23/5. 26/5. 28/5.		

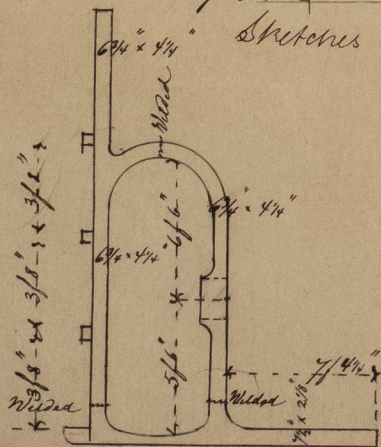

Sketches of Frames showing position and description of welds.

D. G.
5/6/83



© 2021

Lloyd's Register
Foundation