


Proportions
Breadth in Length 6,85
Depth in Length 13,34

Største Lengde	26
Lengde mellem Perpendikulaar	25
Største Bredde	37
Dybde i Rummet	17
Do. fra Hylens Underkant	18
Tons (gammelt Maal)	
Nominations Brekkræfte	160
Classer	500 fl. i et Skæppe

$$\begin{array}{r}
 18214,65 \\
 + \frac{1}{10} \quad 1821,46 \\
 \hline
 20036,11 \text{ Number for Equipment}
 \end{array}$$

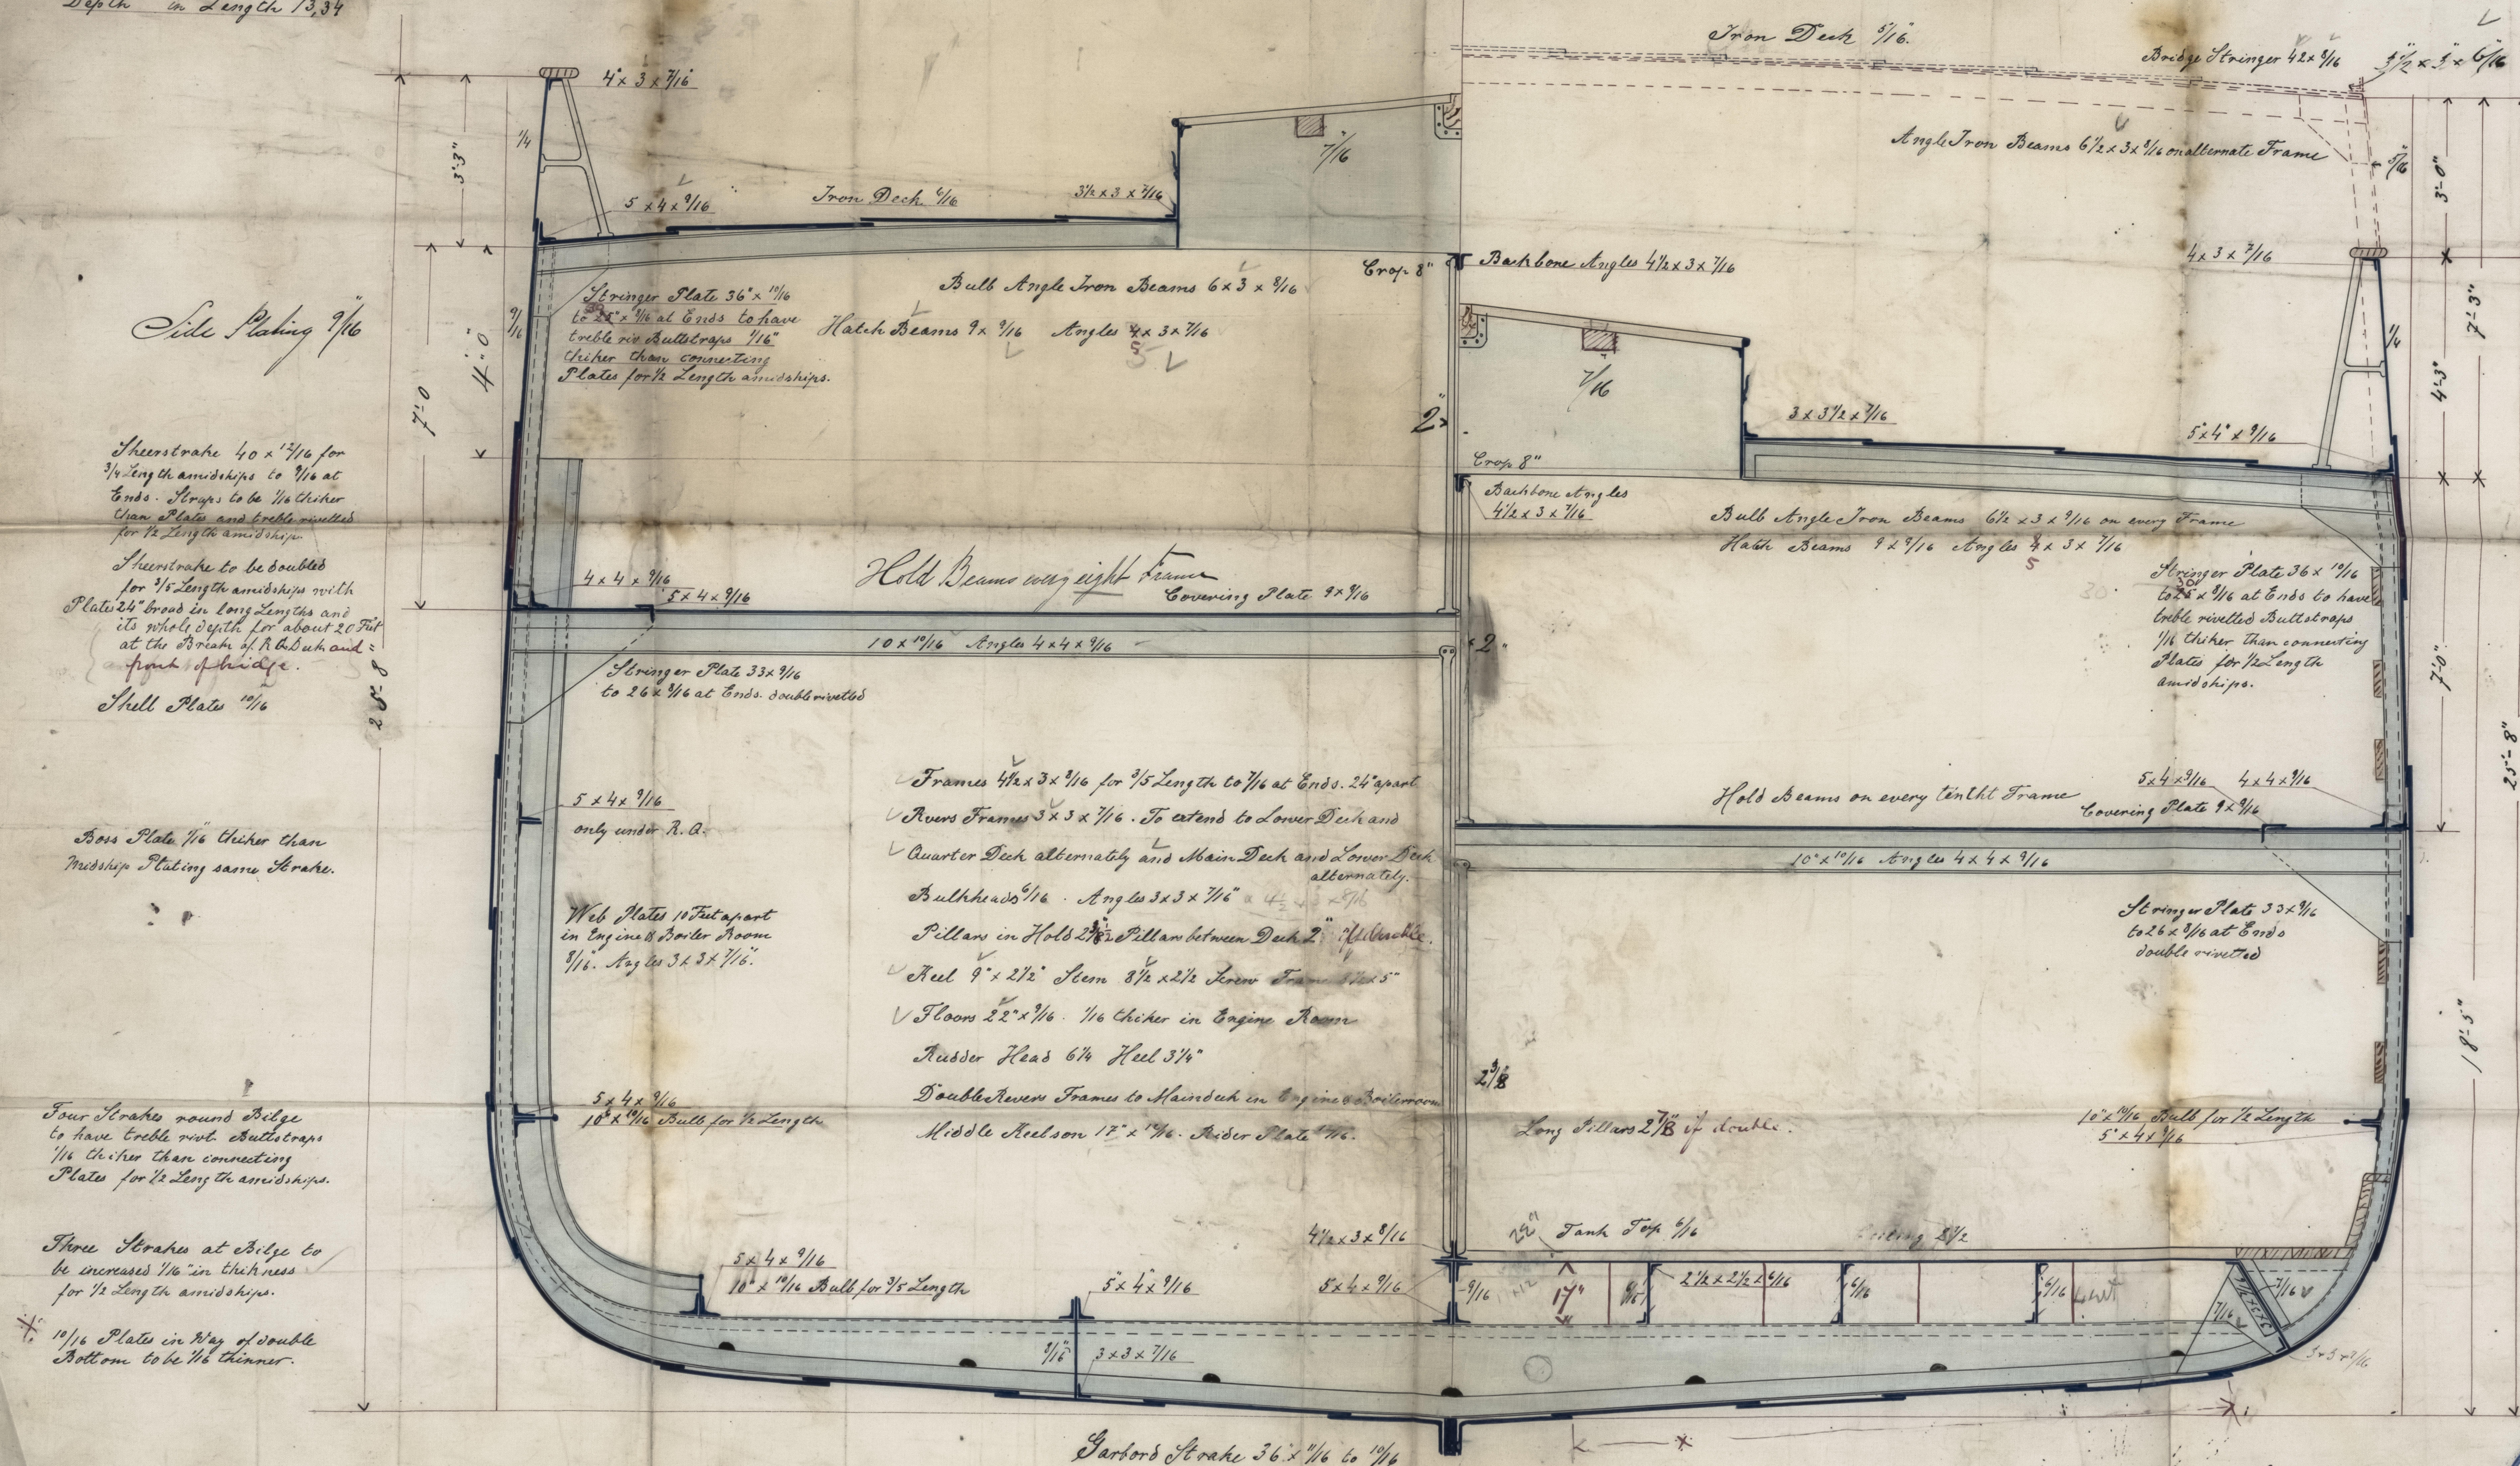



 Martens, Olsen & Co.
 Løxevægg
 No. 41 April 2nd 1883
 BERGEN.