


Profile S. S. No 14.

to Bgn
3/3/84.
4/4/84

Wm. Oldman's Arrangement
Shower in Red Chamber
a shower in Red Chamber

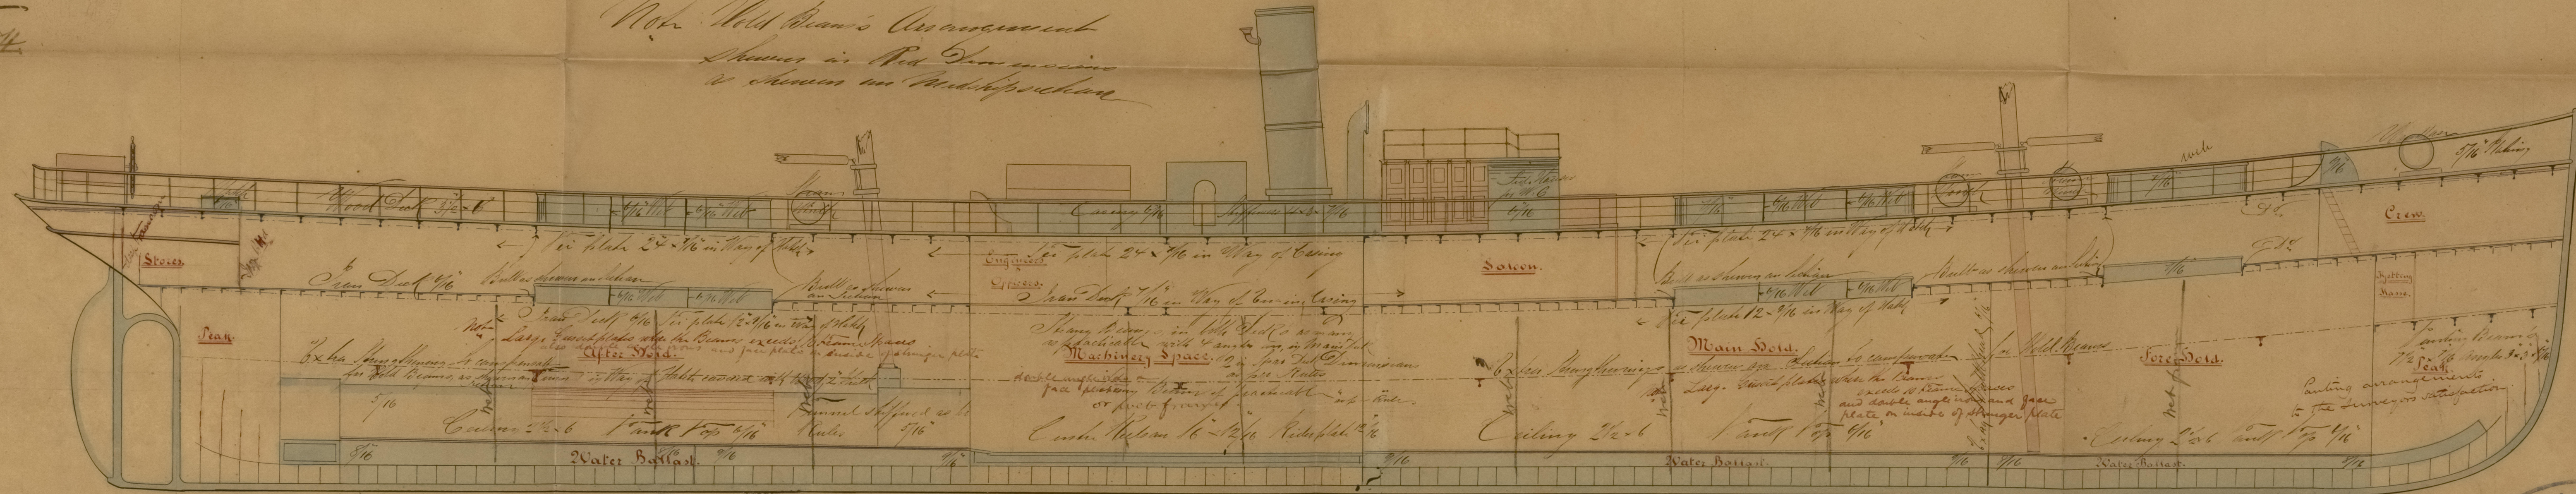

Scale 1/8" = 1 Foot.

Net frames in lieu of hold
beams shown in pencil.
Recd from London 1/3 84. exp.

Received 1/2 84

1/3/84
Exp. 1/2 84

Martens, Olsen & Co.
Laxenbaag
BERGON