


Deck Plans of an Iron Sailing Ship. No 24.

21/1/86.


Plan of Main Deck.

Main Deck String plates 42' 1/2" to 28' 1/2" at ends, built up. Butt straps, 16' built up connecting Stays, for 12 length Gunships

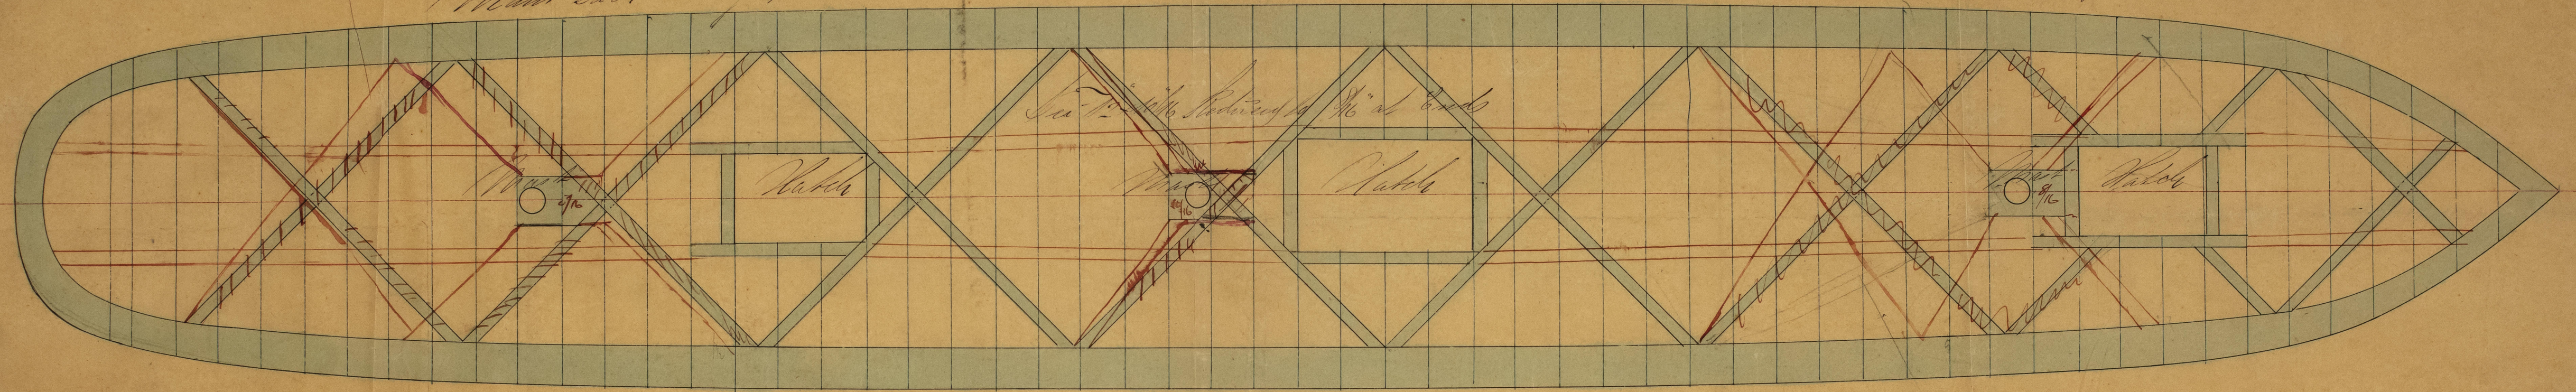

Plan of Lower Deck.

String plates 31' 1/2" to 12' 1/2" length Gunships
12' 1/2" at ends built up

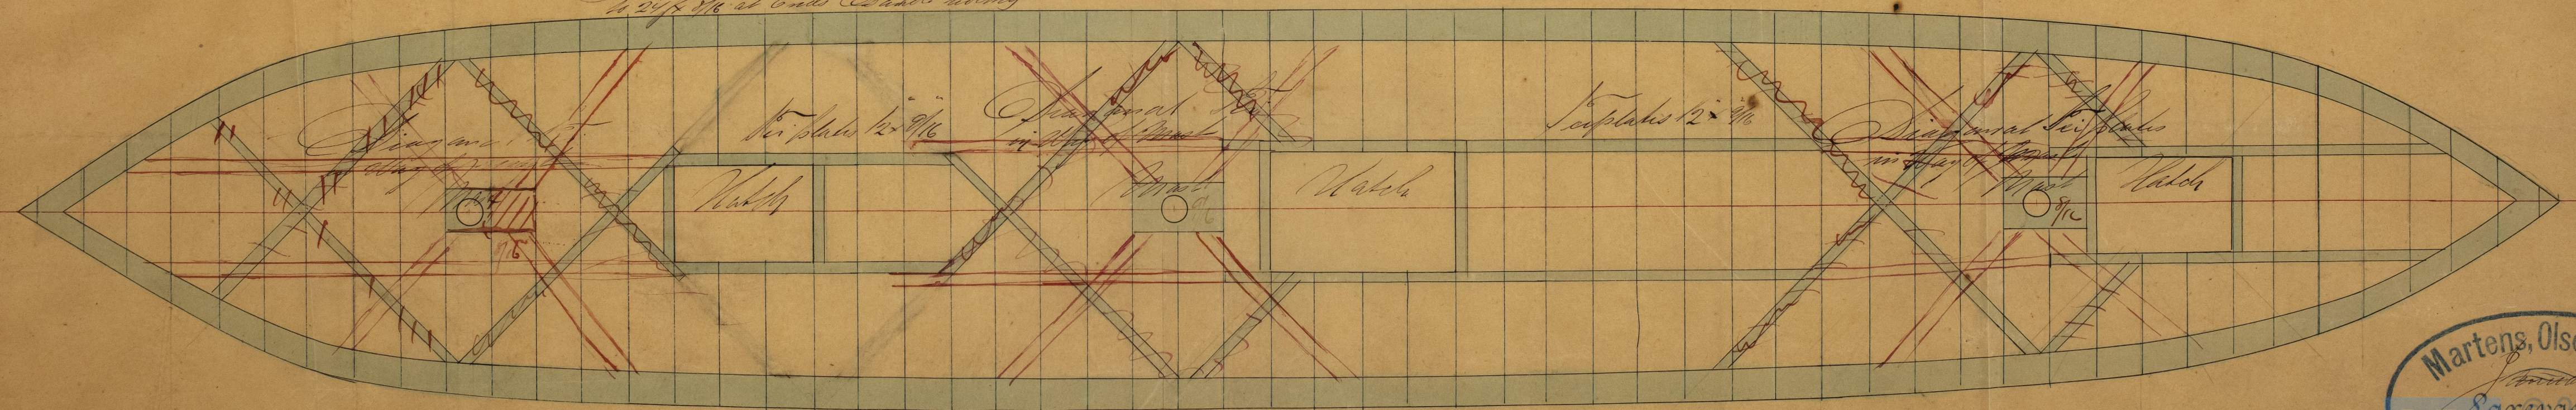

Scale 1/8" = 1 foot.

Rev. 9/1/86



1/1/86
21/1/86