


21/1/86

Profile of an Iron Sailing Ship. No 24.

Midship Section & Profile showing Quarters Deck  
when sent for Copenhagen 22<sup>nd</sup> Decr 1885

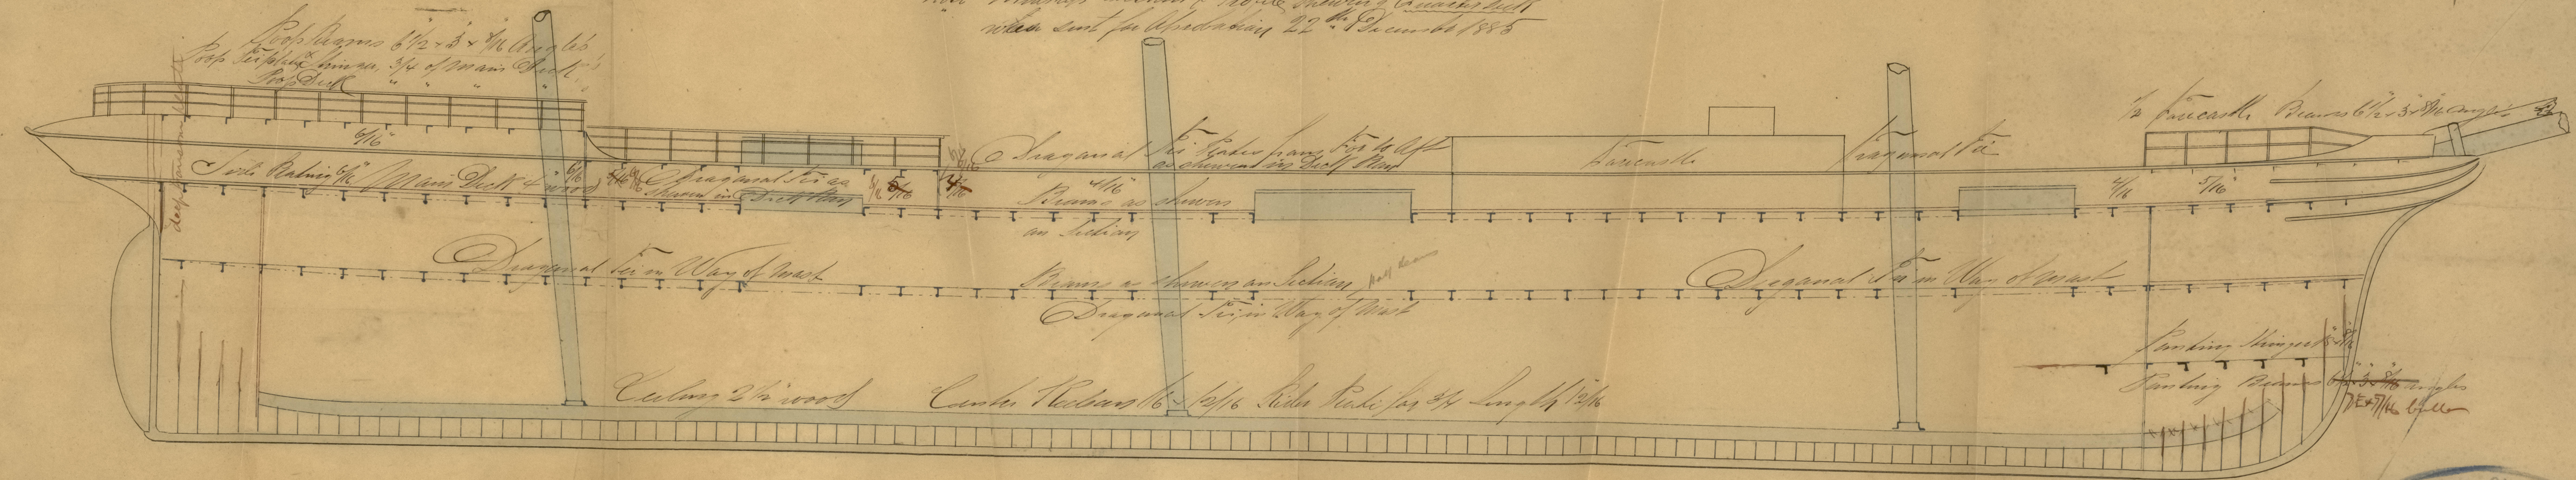

JH  
21/1/86

Scale 1/8" = 1 Foot.

Recd 9/186 EY

Martens, Olsen  
Copenhagen  
1885  
BERG





Marshall's Green  
B.R. 1106/35



© 2021

Lloyd's Register  
Foundation