

"Australia"

*of our Great  
Sailing Ship* Yard No: 24

Dimensioner:

	FOOD.	TOMMERS.
Største Lønge	2 1/2 "	6
Lønge mellem Perpendikularer	2 1/5 "	0
Største Brædde	2 1/6 "	6
Dyldte i Rummet	20 "	11 1/2
De. fra Hjælets Underkant til øverste Dek	2 1/2 "	3
Tone (gammelt Maal)		
Nominelle Beskrivelse		
Class	10 1/2 " 1/2 "	

*Equesmus* n° 17318


1/2 Brazil 7. 75  
 1/2 Gink -- 35. 25  
 Wash -- 22. 96  
 75. 96  
 x Leno 25. 75  
 100. 71  
 100. 71







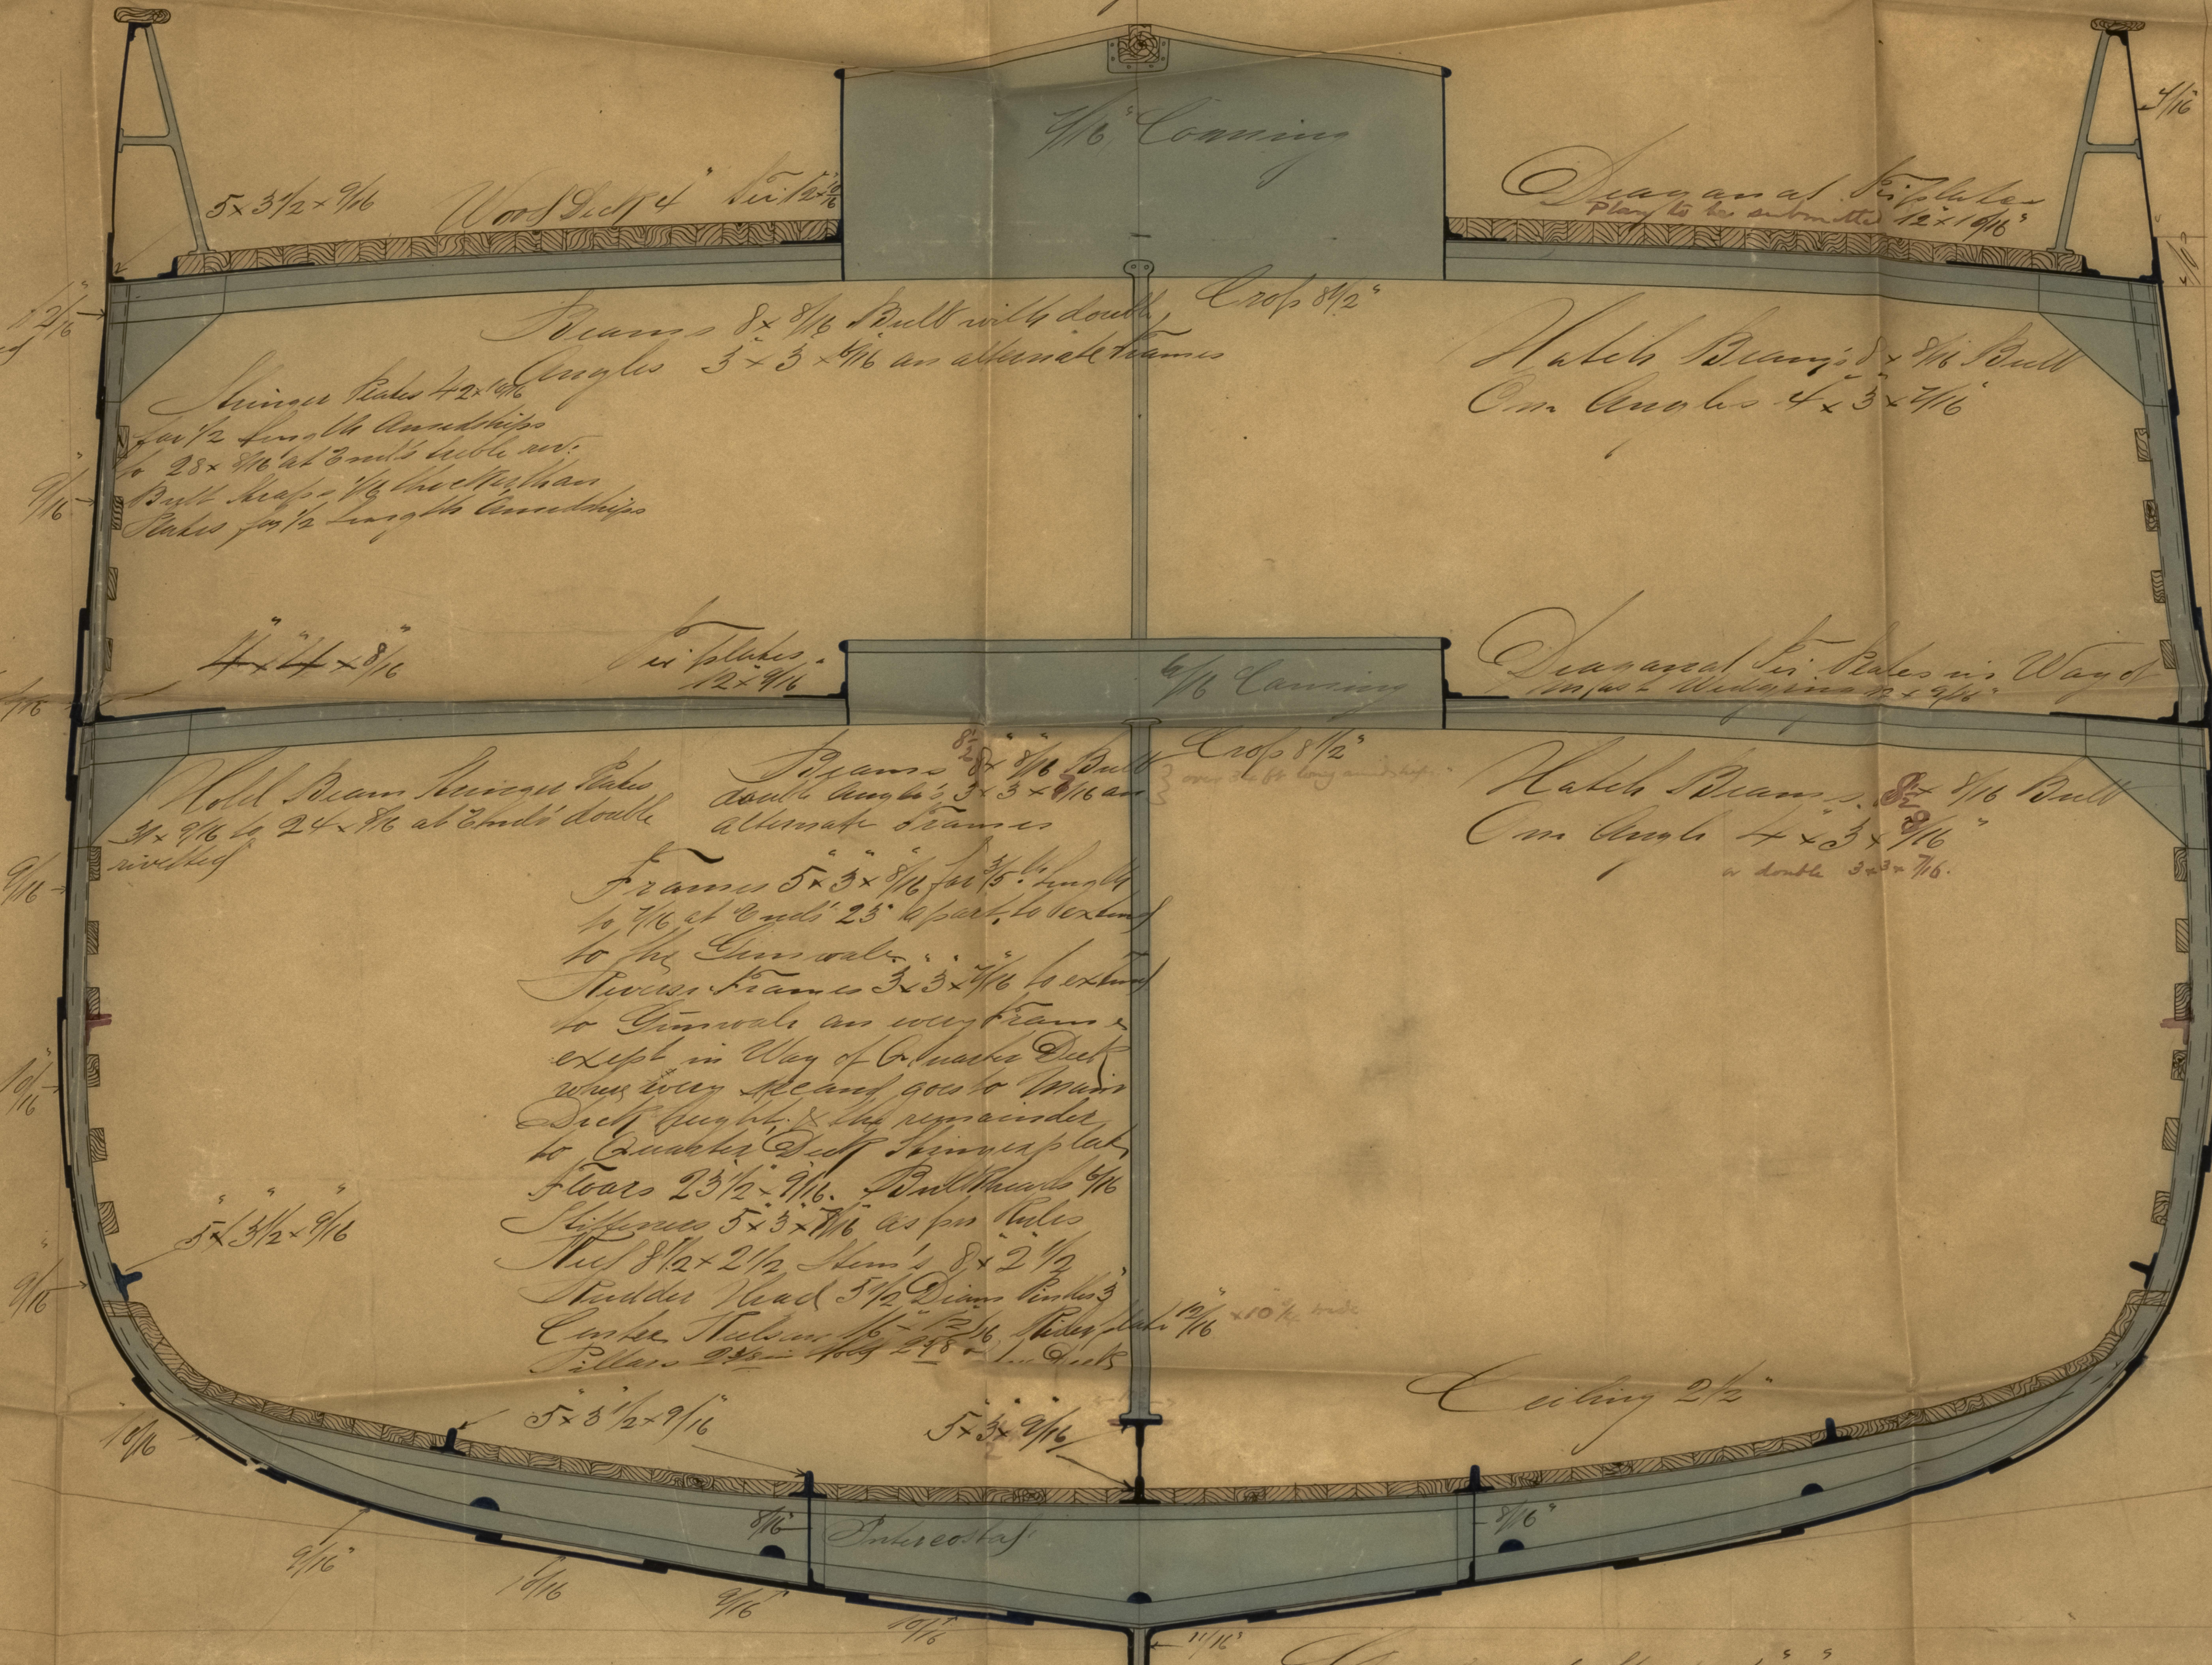

Garboard Stalk  $34\frac{3}{16}$

Martens, Olsen & Co.  
Ladegaag.  
Bergen.

Received 27/12 85 EL