


# Ceta

Recd 4/10/73 & 14/10/73


Proposal to Lloyd's Sept 20/73.  
 To build vessel of 300 tons and disburse into Shipping.  
 Dimensions Length 134 ft. Beam 25 ft 6. Depth 13 ft 6 inches  
 To be planked with Pitch pine for 9 years  
 To have top side 3 strakes & sheer strake of Seal or Oak  
 Frame throughout including stem stem post & beams  
 Planked of English Oak one year 10.  
 To be salted 11  
 To be metal fastened according to  
 Proposal arranged 2 years 13 years  
 To have new ridges to each deck beams to bolt to floors  
 between fore and main mast as mentioned last to  
 compensate for extra depth and disbursement into Shipping  
 on the frame

John Scott  
 Indefatigable  
 Sept 20/73

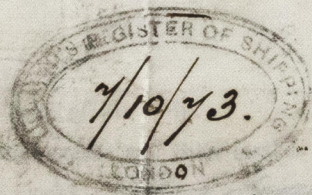

Sr. 23/10/73

13  
 13  
 15

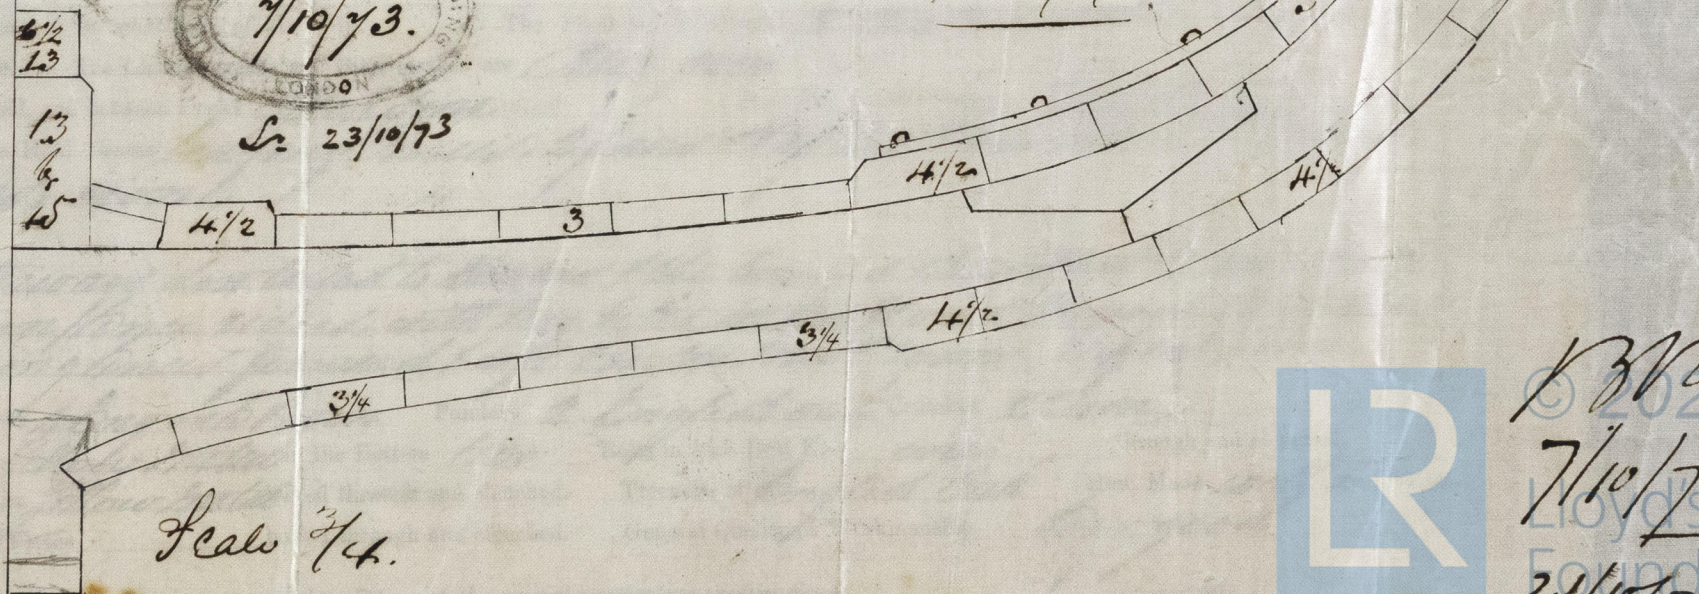

Scale 1/4.



© 2020  
 7/10/73  
 Lloyd's Register  
 Foundation  
 21/10/73