



"A DOLF TIDEMAND"

Drillings in black ink starboard side.
so Red ink Port side.

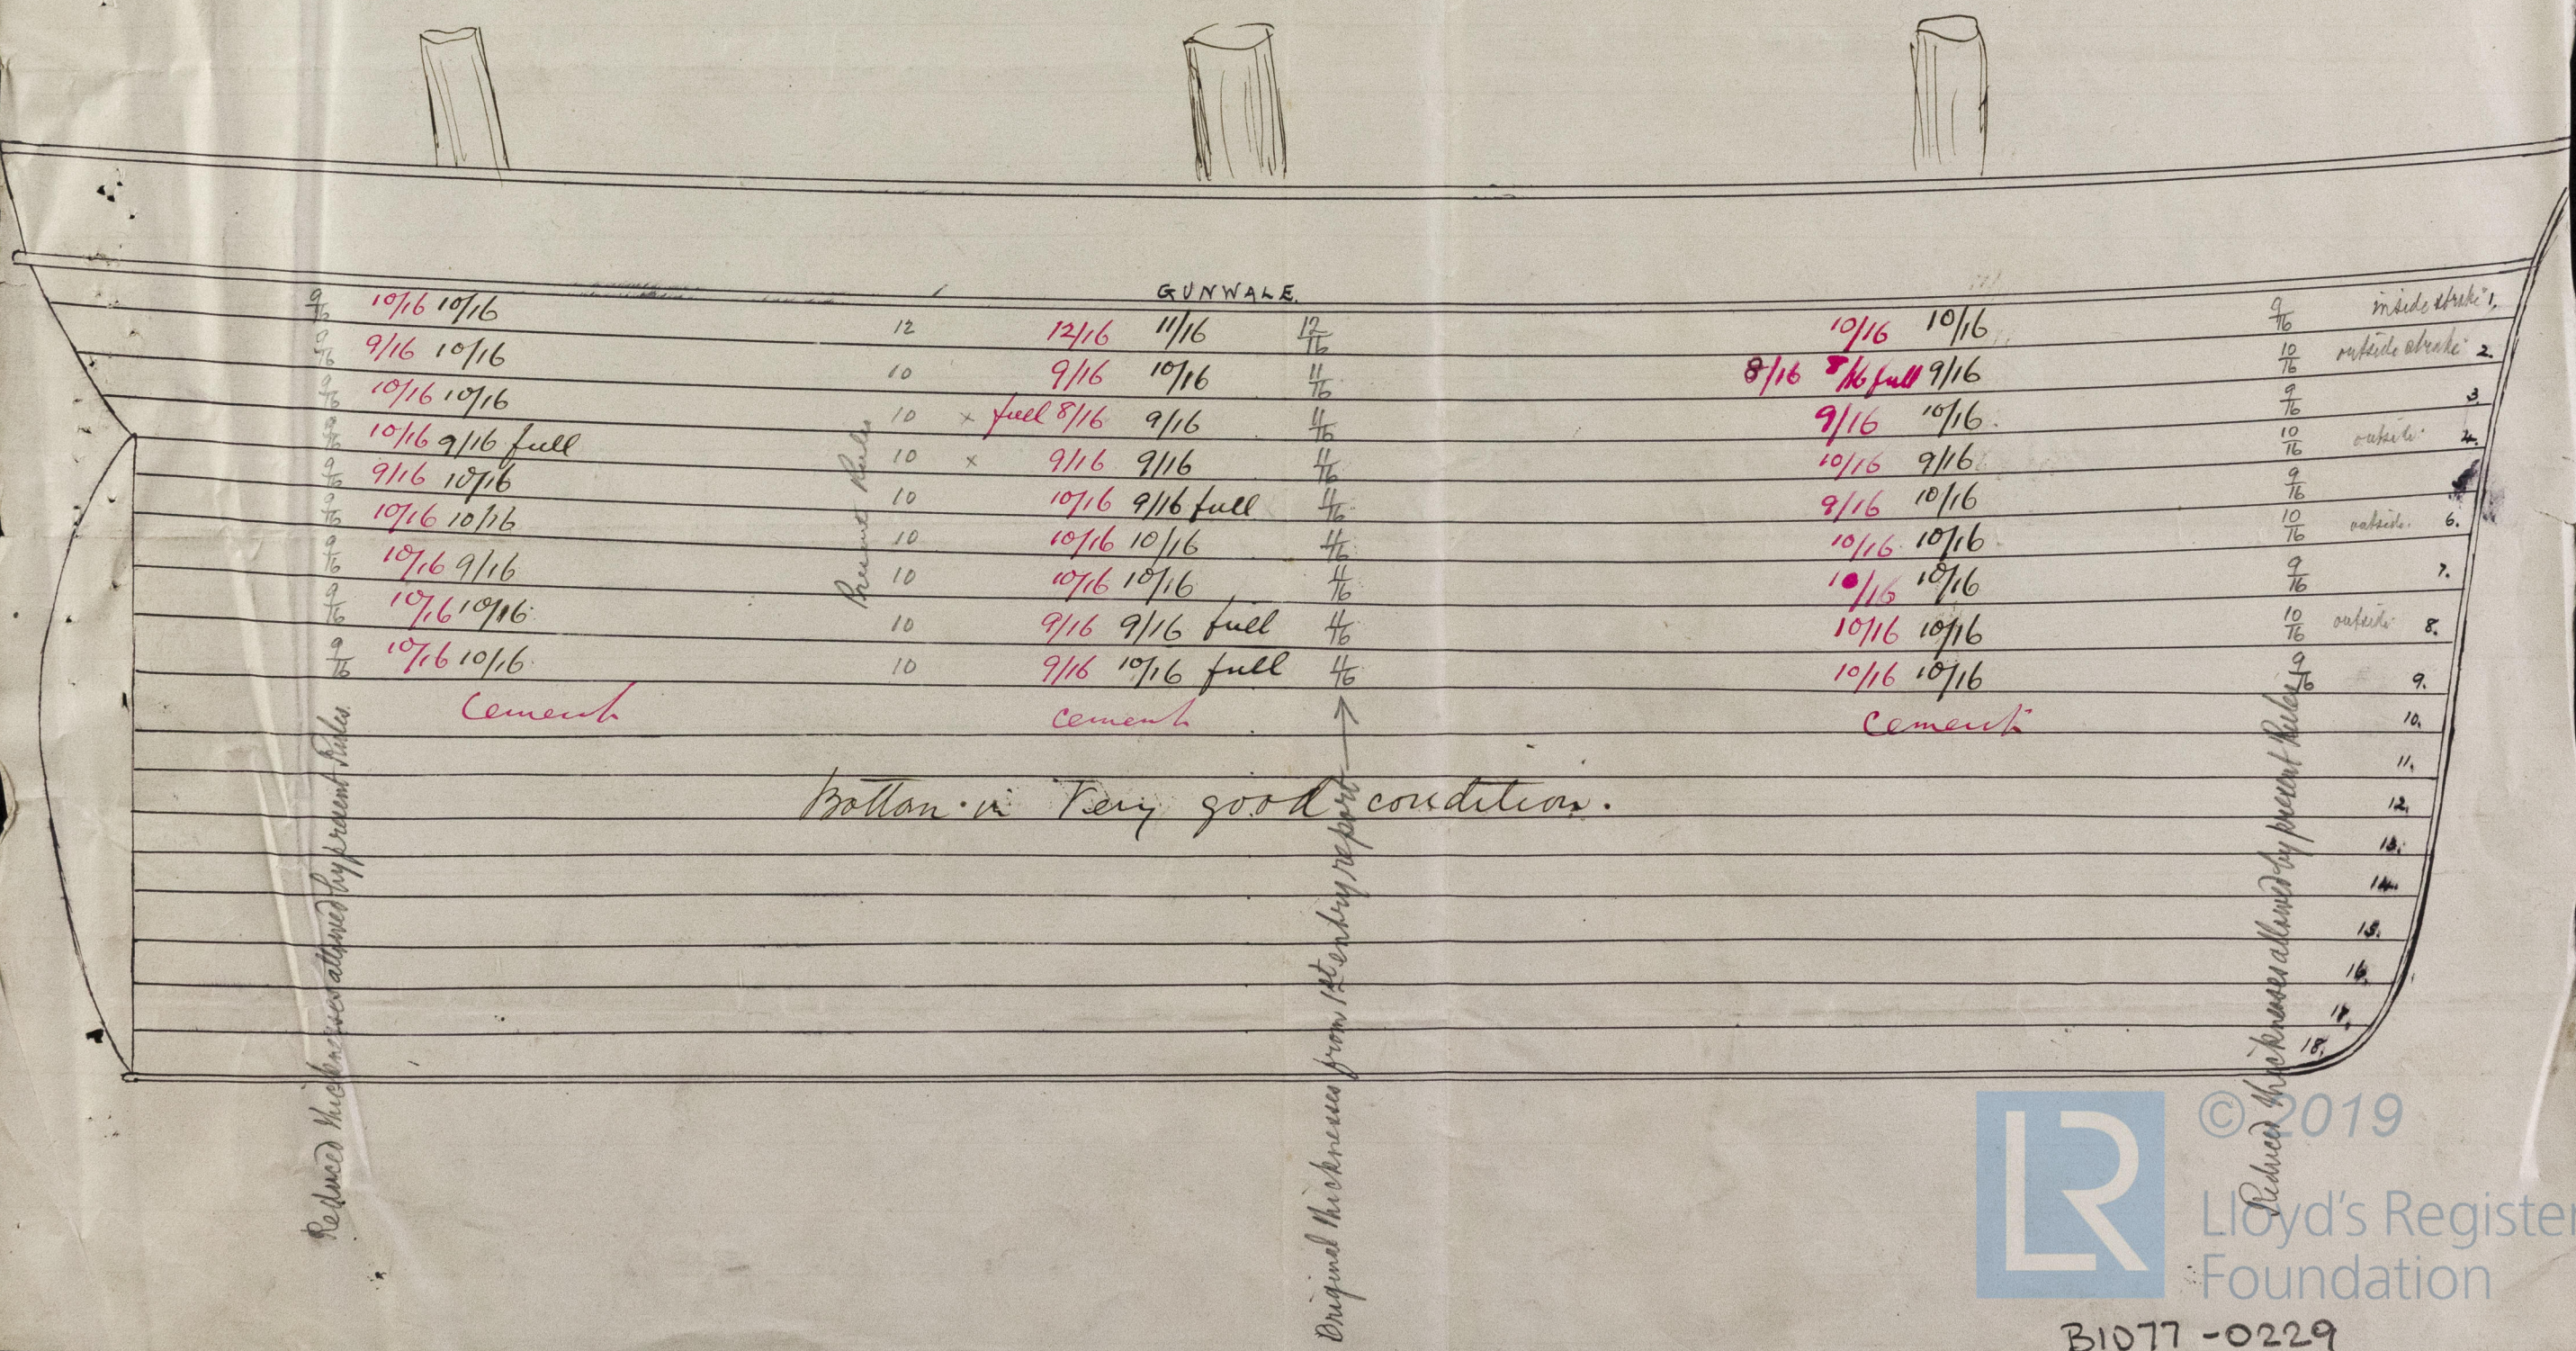

B1D71-0229

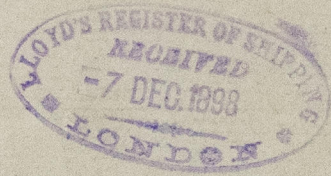

© 2019

Lloyd's Register
Foundation