


Copy.

Midship Section of s. "Hannibal." Now "Adolf Tidemand"
 $\frac{1}{2}$ Inch Scale

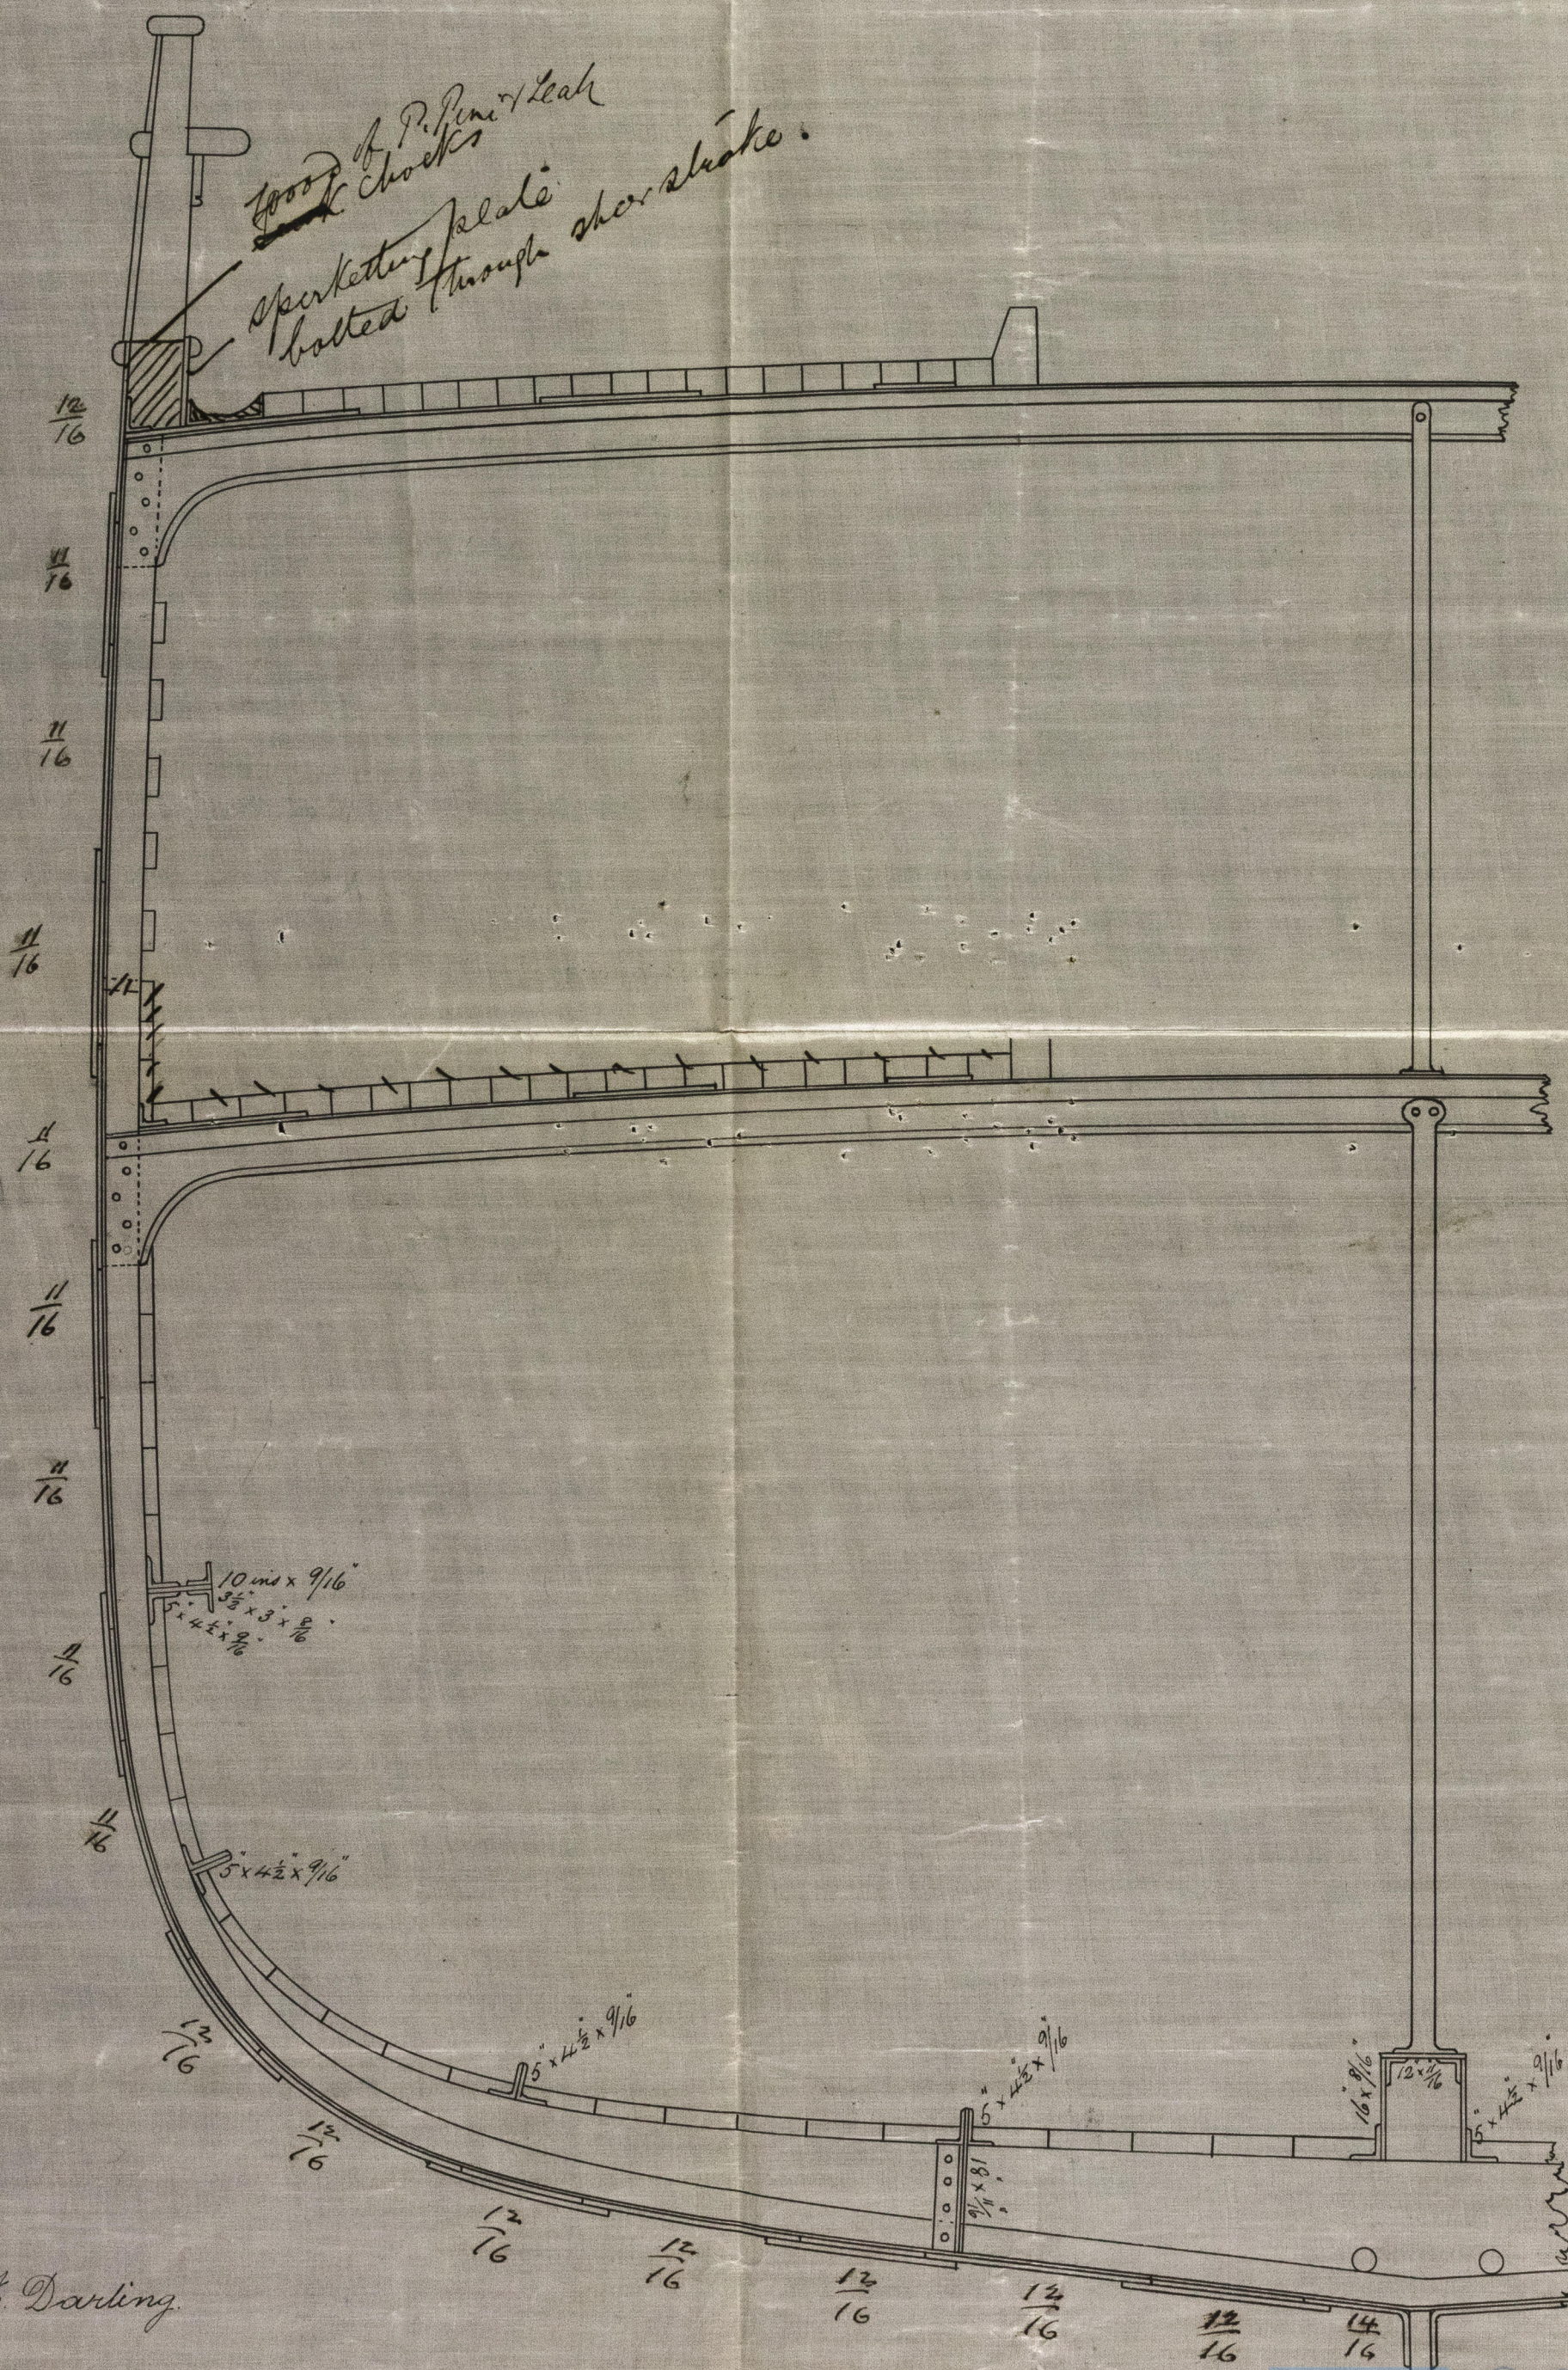



© 2019

Lloyd's Register
Foundation