


S/S "NEW ZEALAND"

150' x 22' 6" x 12' 4" MLO  
152

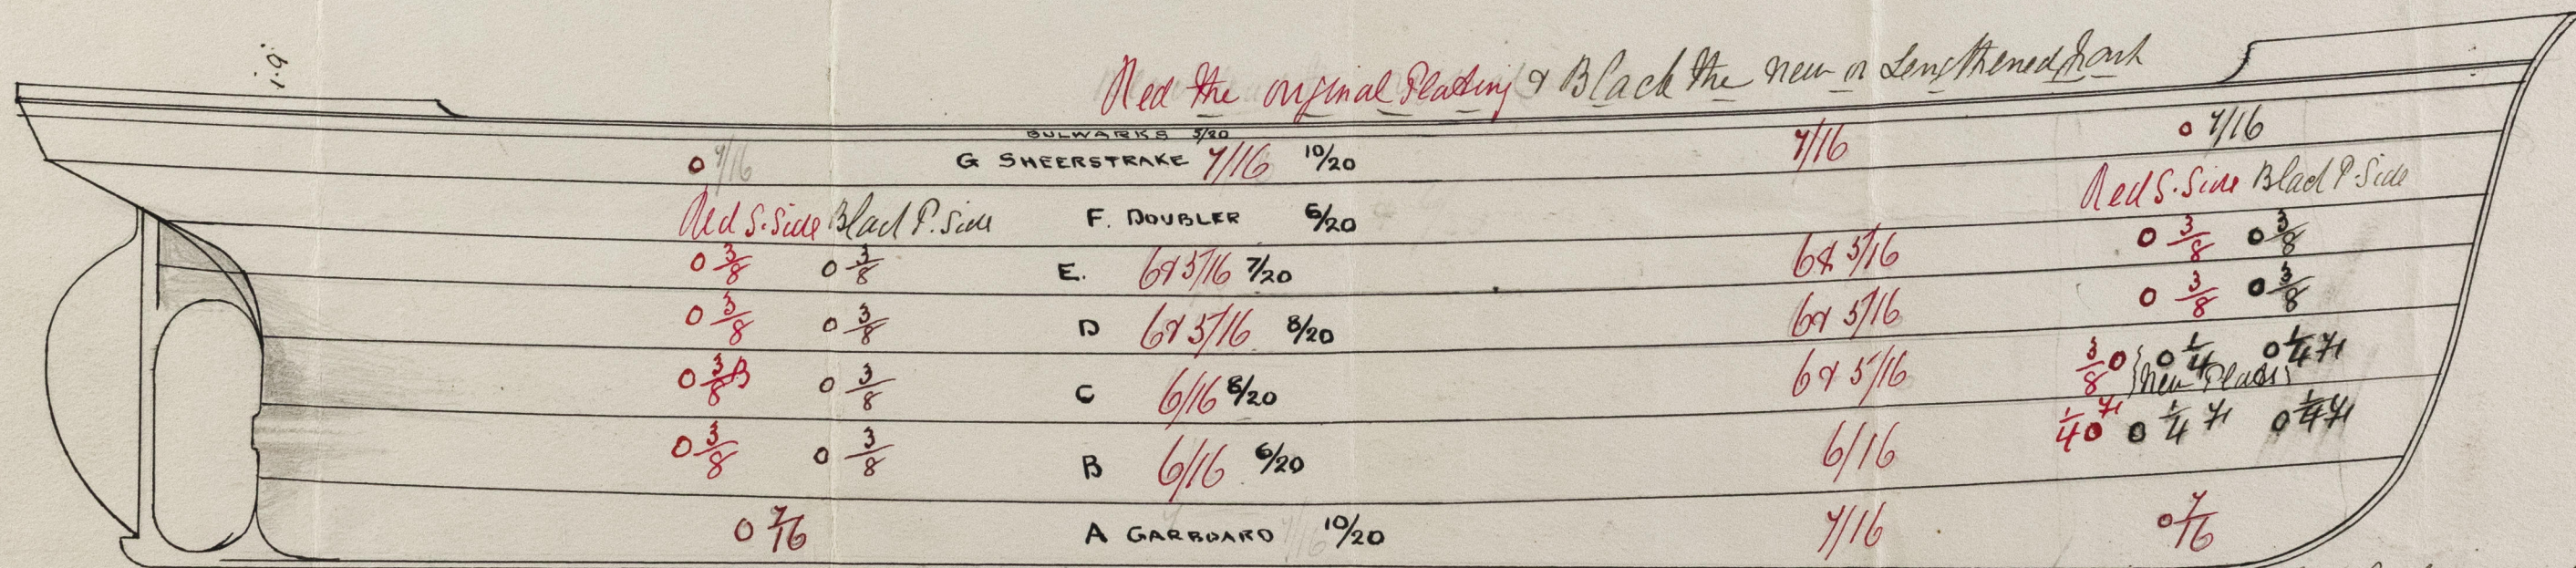

Plates: the both Bows doubled  
when found slightly thin