


# Half-beams in the Barge "Vegs"

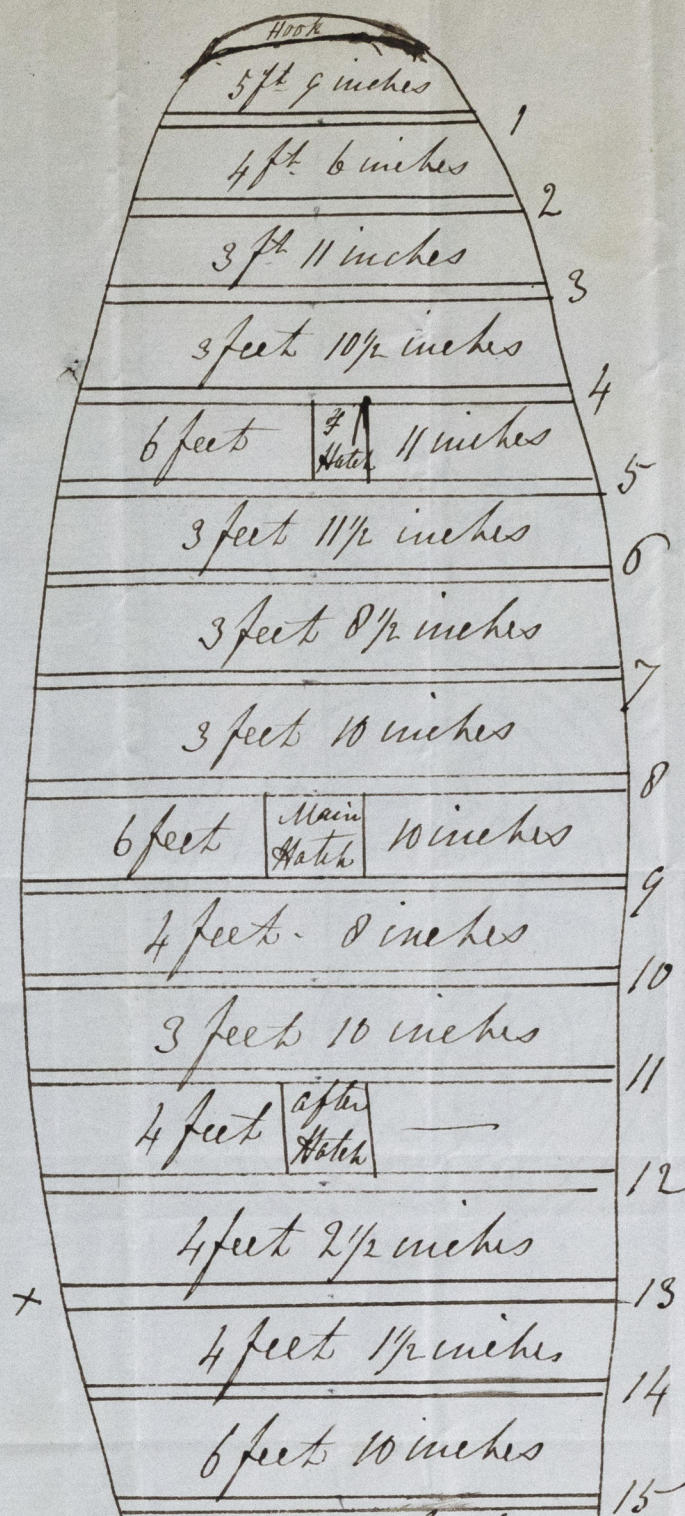

the space of this beam from the Transom could not be ascertained, as there was a bulkhead up, but I think not more than 5 to 6 feet from the Transom.

+ This beam forms the break of the Cabin Deck. The siding of each beam is 11 inches, some are half an inch more.



© 2019

Lloyd's Register Foundation

BRS 741 - 0302