


Sheerstrake 4"

Wales 5 feet in width
of 5" plank
tapering flush
into Sheerstrake

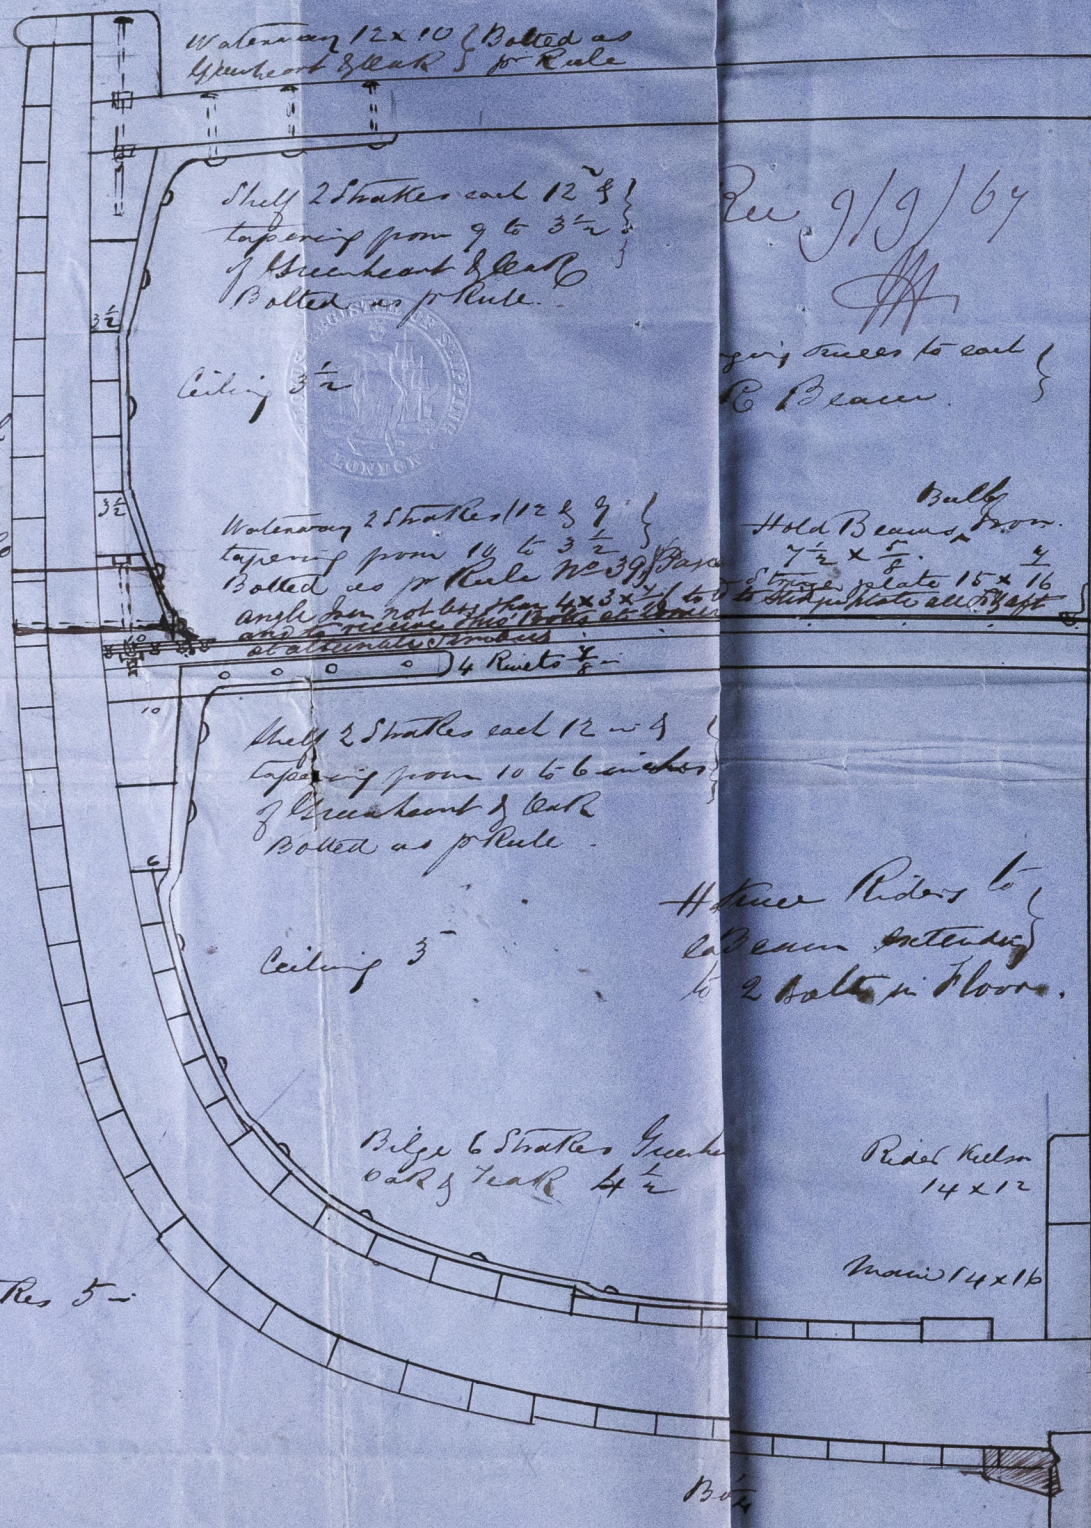



Bulky
Hold Beams from
7 1/2 x 5 1/2 to 4 x 4
Storage plate 15 x 16
to ship plates all right

Angle Iron on Beams 3 x 2 1/2 x 16.
double angle beams at
middle line 3 1/2 x 3 x 16.


Barque Building at Gloucester
by Mr Barnes for the G.M. Co.
Syr. material & fastenings.

Dimensions: - 140 (on deck) 1 x 26 x 14 1/2
Tonnage about 320 tons N.T.

Keelson back
Greenheart.

Jackboard Strakes to be not less than
6" thick at Keel and 4" thick at
upper edge to be well fastened
bolting them horizontally through
the keel, to be left optional

9000-185281

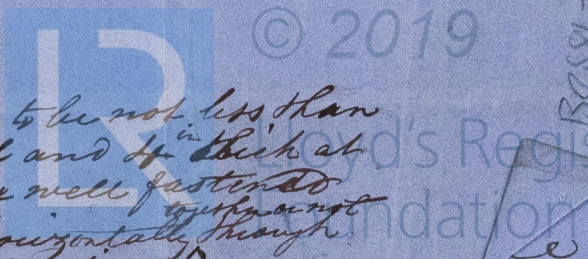

Vessel by Naval
350 tons. Shota

Shota



© 2019
Lloyd's Register
Foundation

3rd Ditto.....
Bilge to Wales
Wales
Lumber Planks
Bilge Stra