

Frame fastened with Galv'd Iron 1 Year

Y. Metal fractured


Saturday

Built Under Seal

per Charles Hill Esq  
R. Hancock

This sketch shows sizes as per rule

This sketch represents the ship as built

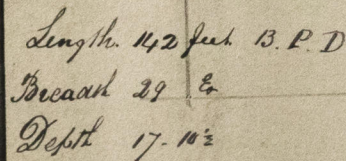

Apes Creek 3  
Fore. H. 3

Scale  $\frac{1}{2}$  in to a Foot.



Rec 19/11/99



de 25/9/77

© 201

Lloyd's Register  
Foundation

BLS81-0238