



50

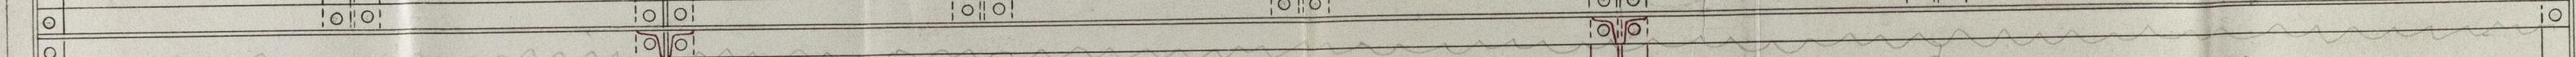


A.

—Scale .34" = one foot—

B

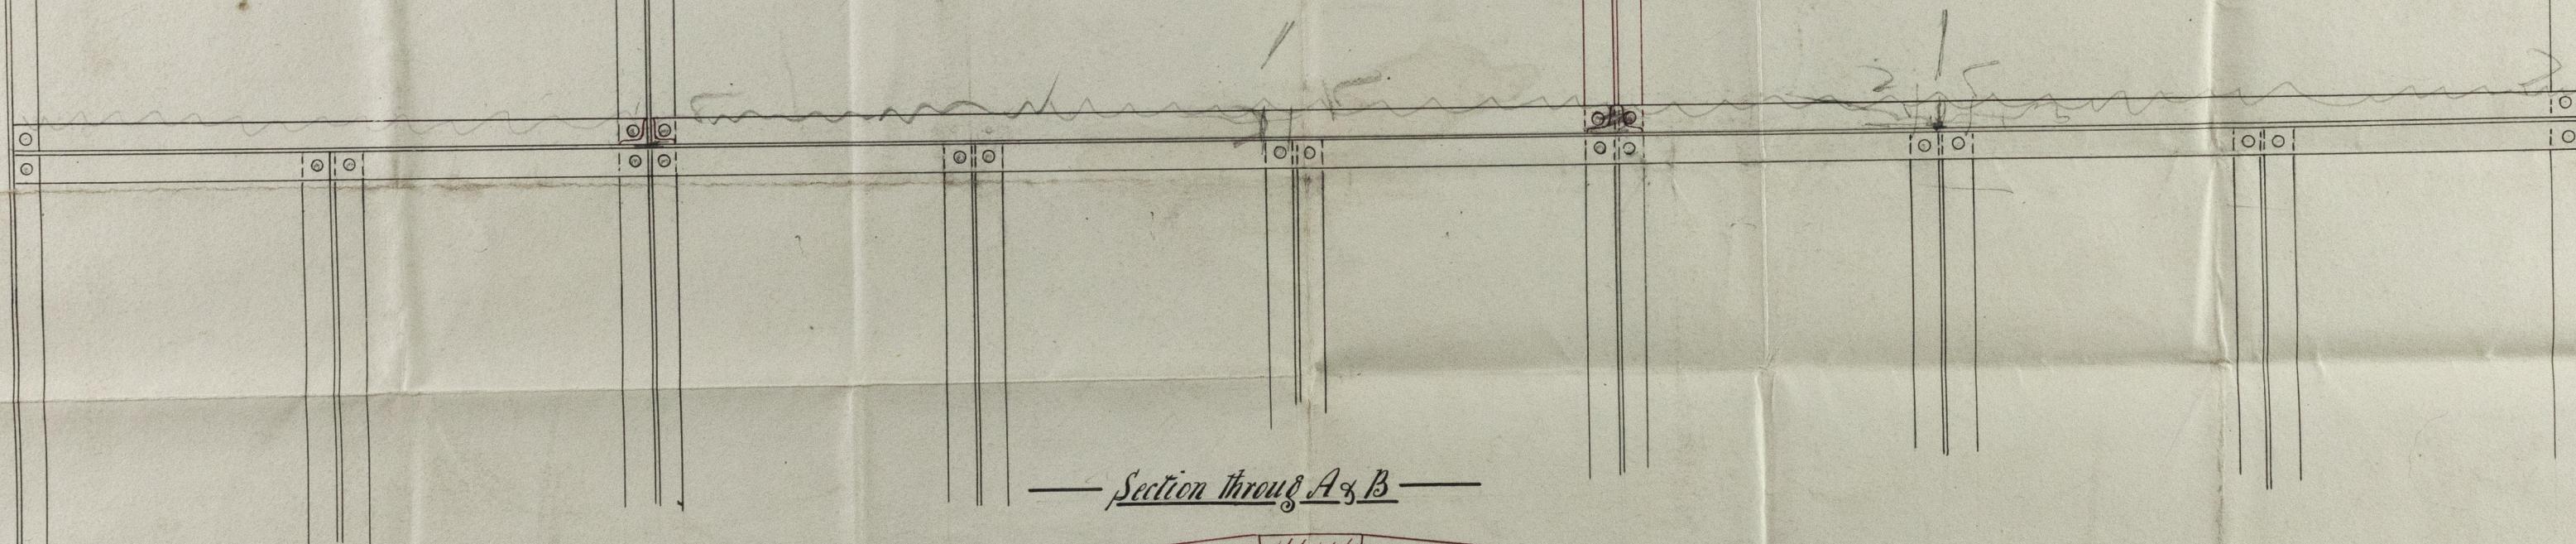

—Section through A & B—

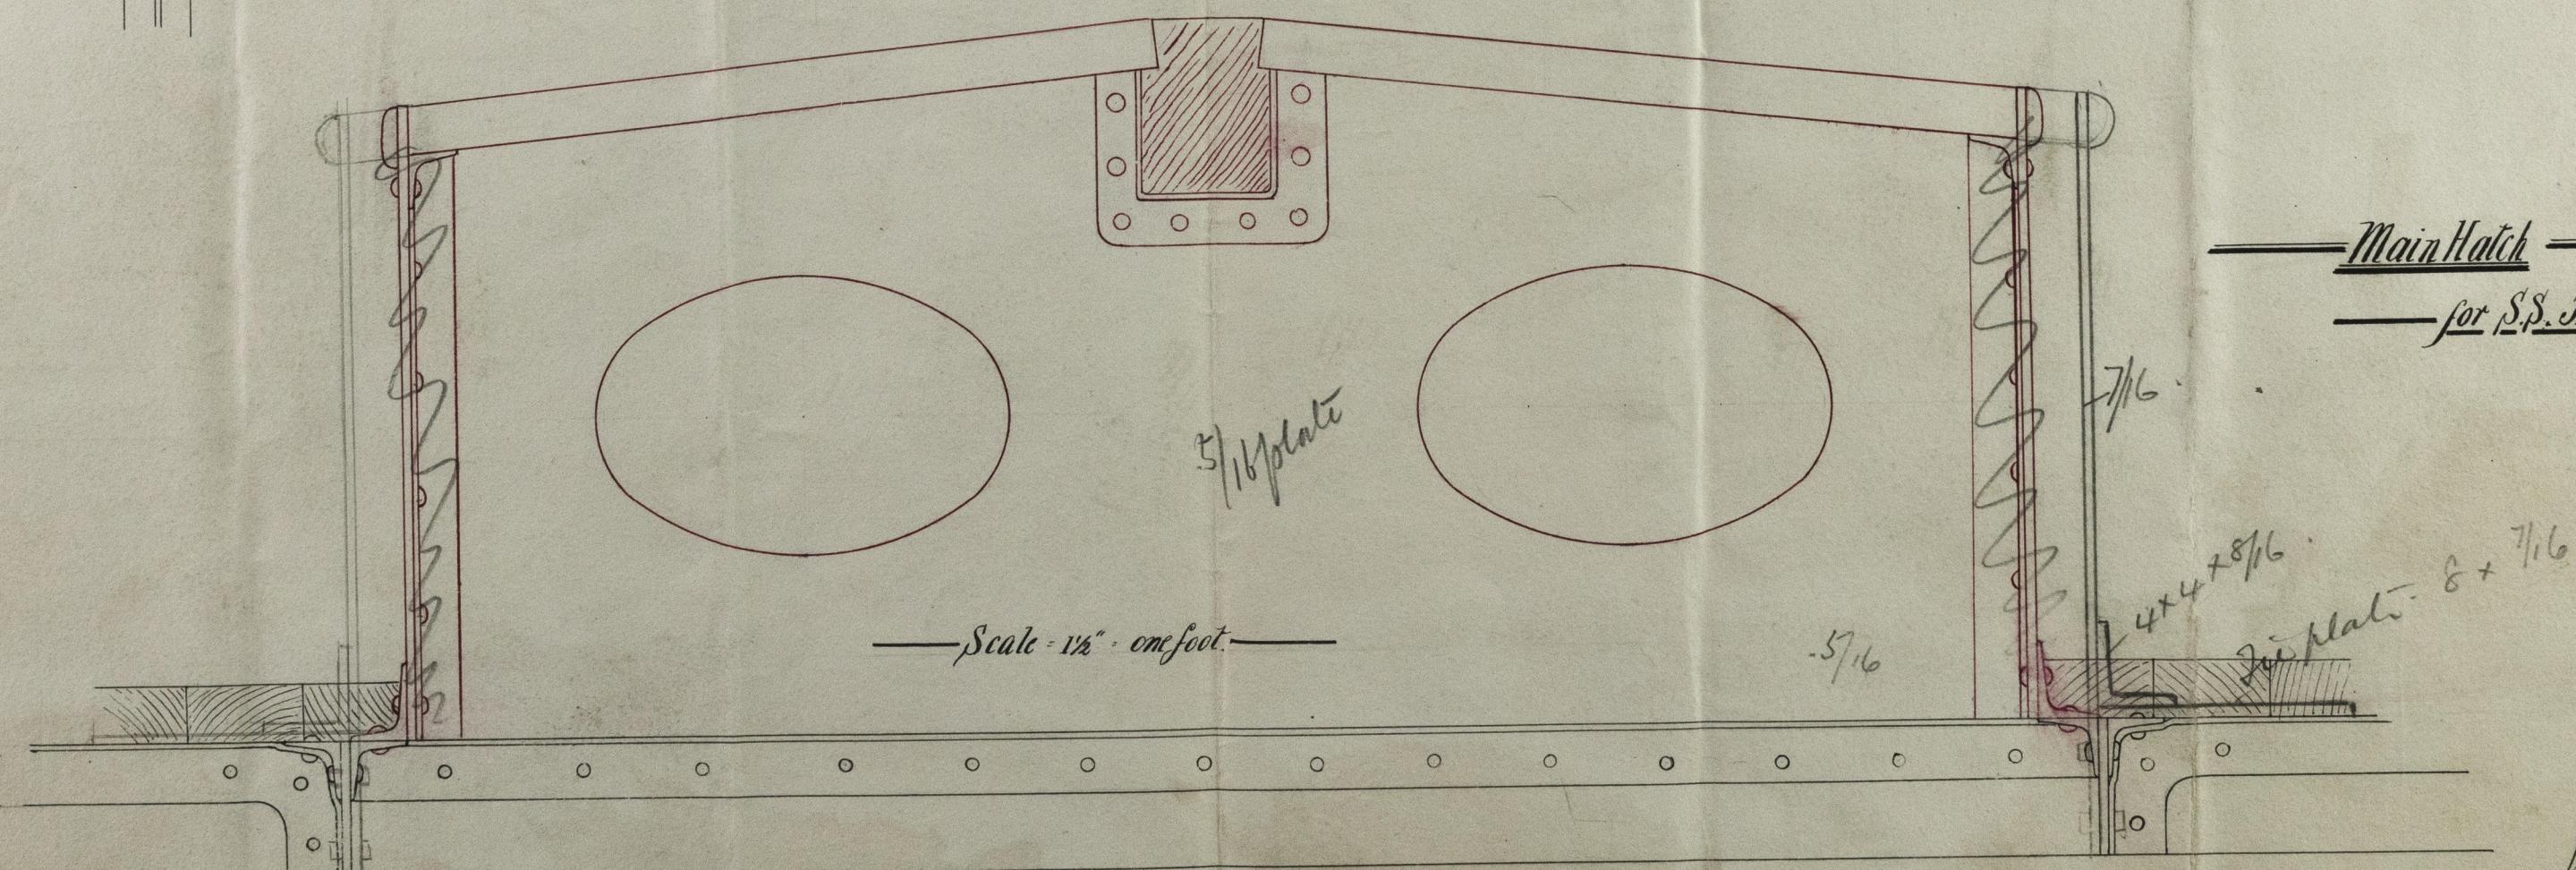


—Main Hatch—

for S.S. Jhos. Powell.

G. K. Fletcher
J. M. Mullings
3rd April 1882