

RECEIVED 26th JUNE 82.

Rec'd  
Winter Office  
5/6/82  
Jy.



10.6.82

Gallop  
Bus No 4217

Light depths } in length  
Five breadths }


Length 75 ft 0"  
Breadth 15 ft 0"  
First No. 32  
Second No. 2400

— Midship section —  
— of Tug boat No 84 —




June 5<sup>th</sup> 1882

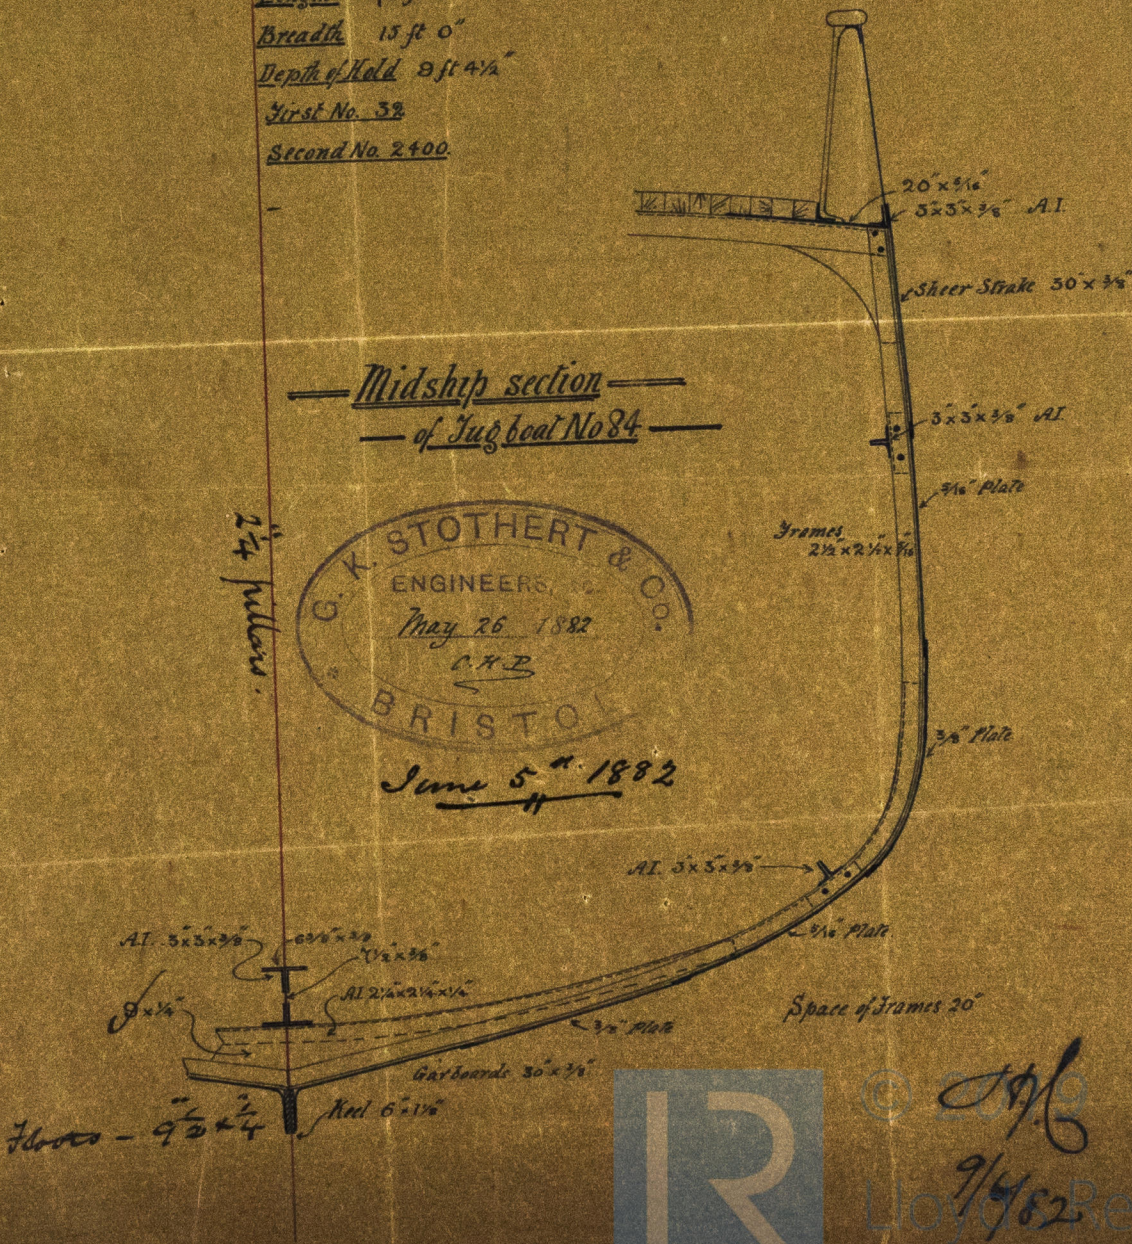

Lloyd's Register  
Foundation