




Dr. & Bos.  
14/9/83

S. S. William

No. 277 in Register Book.

Bristol Prop 4313

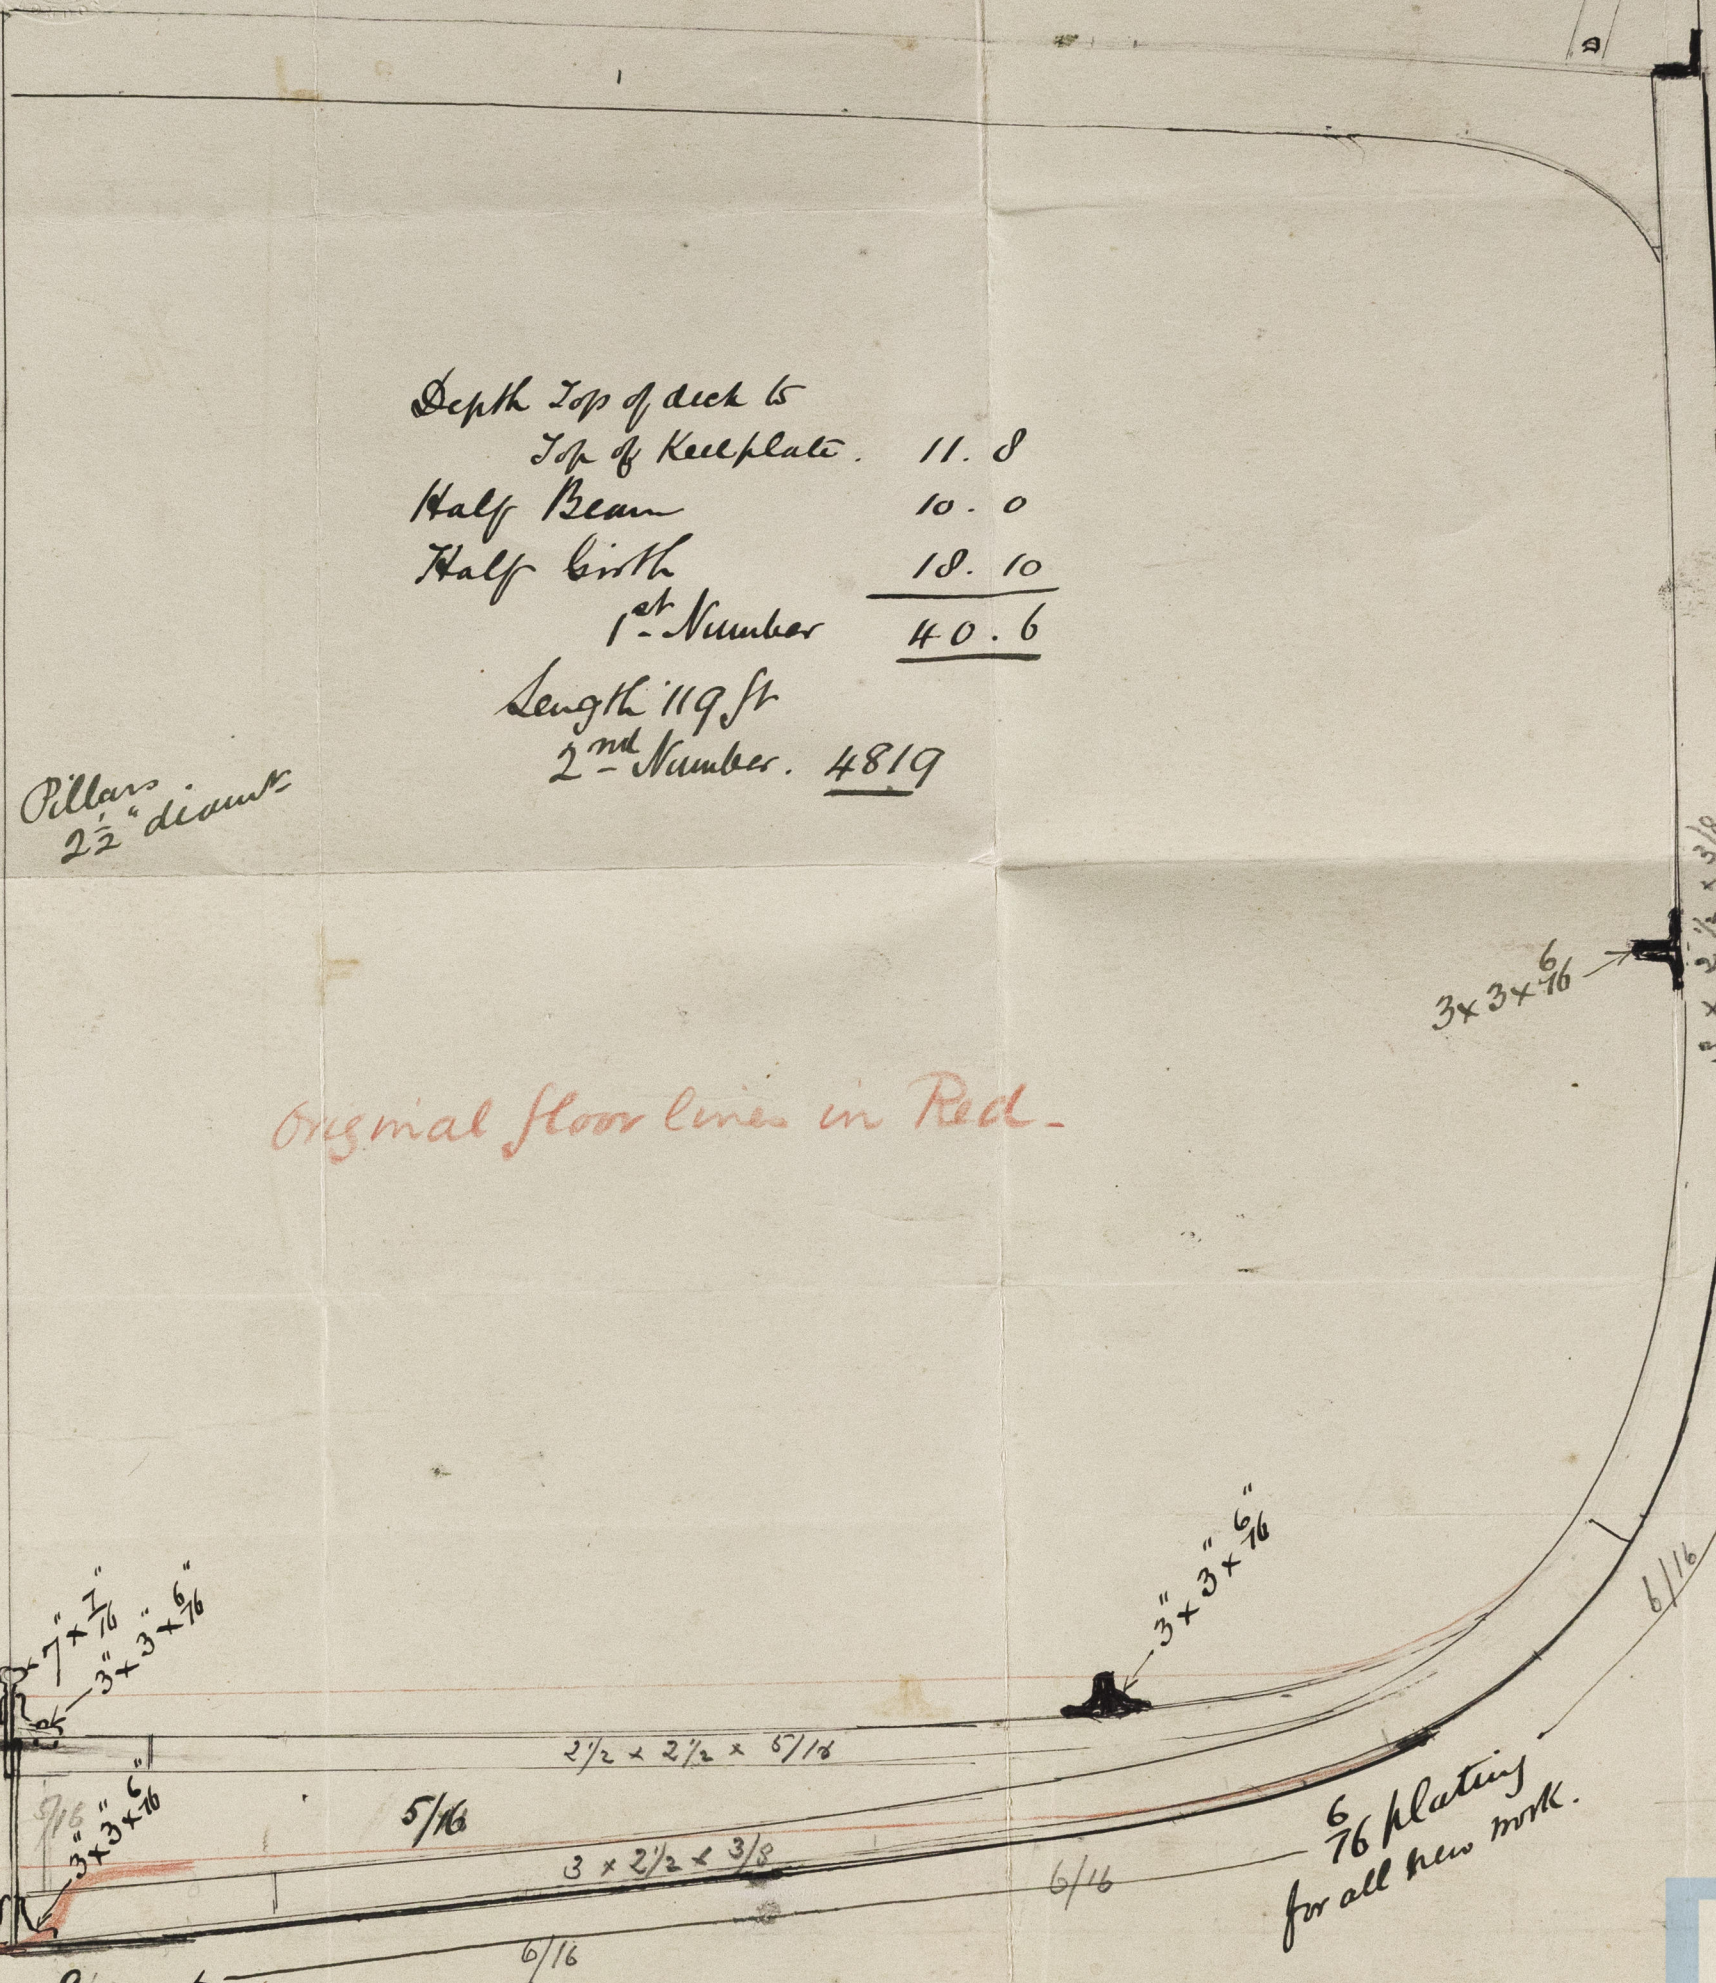

8.4 1/2  
17 1/2  
25.4 1/2  
8.4 1/2  
9.10 1/2  
17 1/2

22 7/16

5/16

One strake with Buttsrap 7/16 thick

7/16 plating for all new work.

Bottom to be cemented to turn of Bilges as required by the Rules



© 2019

Lloyd's Register Foundation

82581-0325