


LOYD'S REGISTER OF SHIPPING  
12 SEP. 83  
LONDON

Ltr: H. Buss.  
14/9/83.

S. S. "William"  
No 277 in Reg. Book. BRS 4313  
Scale  $\frac{1}{4}$  inch = 1 foot.

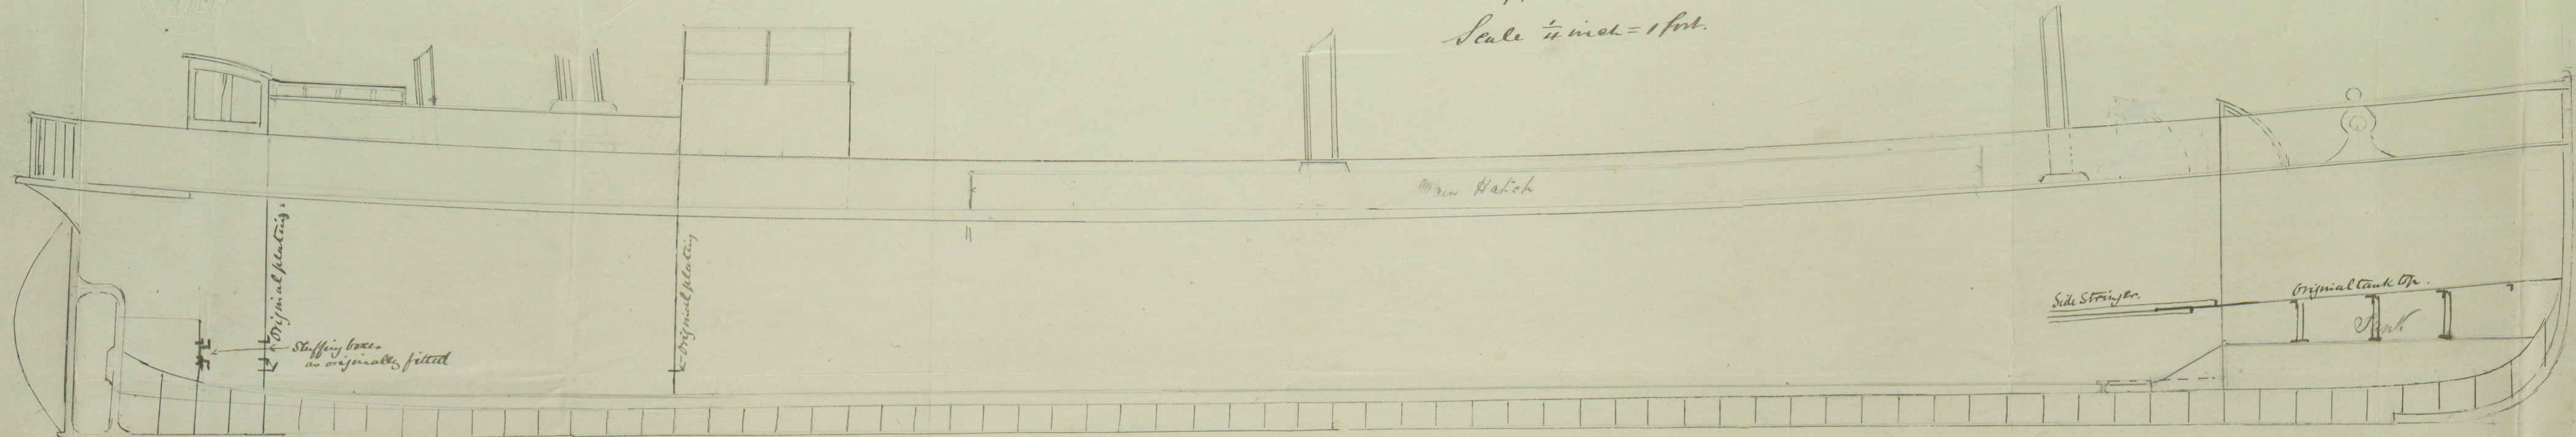

© 2019

Lloyd's Register  
Foundation

82581 0326