

Lloyd's Register of British and Foreign Shipping.

(Report on Vessel No. _____ Port _____)

The words FORGINGS or CASTINGS, IRON or STEEL, should be struck out as may be required.

No. 385.A. SHIP FORGINGS OR CASTINGS.

I have to report that the undermentioned Iron ~~or Steel~~ Forgings ~~or Castings~~, manufactured by Messrs C H Reed & Co. of Sunderland for the Vessel No. 6, being built by Messrs Newall & Co. of Bristol have been inspected by me as set forth below, and found to be, so far as can be seen, sound.


Mark on Forgings.

Lloyd's
No. 385 A
H.C.

Hugh Cummins
Sunderland

	STERN FRAME.	RUDDER FRAME.	STEM.
Material* - - - -	<i>Swag iron</i>	/	
How made - - - -	<i>Forged</i>		
Dimensions - - - -	<i>5' x 2'</i>		
Progress on Inspection -	<i>Forged & finished</i>		
Dates when Inspected	<i>Dec 15. 17. 19. 31/85</i>		

SKETCHES OF FRAMES SHEWING POSITION AND DESCRIPTION OF WELDS OF FORGINGS, OR PARTICULARS OF TESTS APPLIED TO CASTINGS.

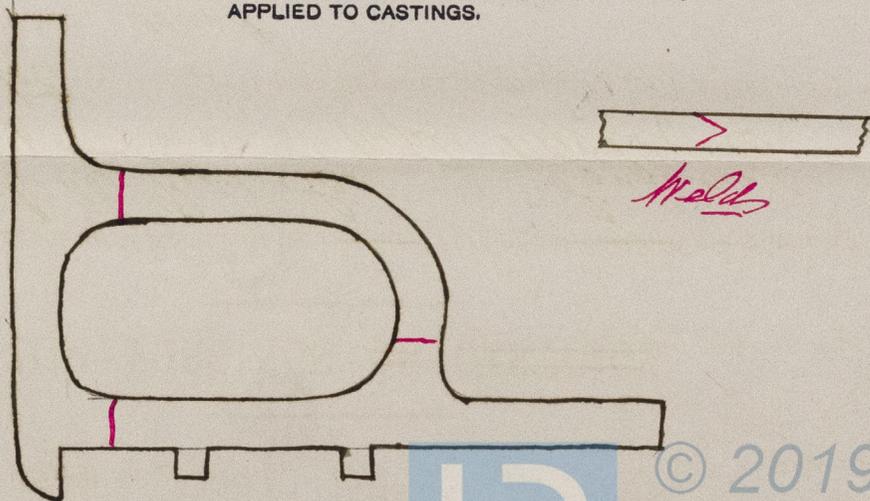

© 2019
Lloyd's Register
Foundation

* If of Iron, state whether scrap or puddled Iron.