

Received at

Office,

18

Lloyd's Register of British and Foreign Shipping.

(Report on Vessel No. Port)

No. 112 a.

SHIP FORGINGS OR CASTINGS.

I have to report that the undermentioned Iron or Steel Forgings or Castings, manufactured by The Darlington Forge Co. of Darlington for the Vessel No. 9, being built by Messrs Chas Hill & Son of Bristol have been inspected by me as set forth below, and found to be, so far as can be seen, sound and efficient.

Mark on Forgings.

Lloyd's

No. 112 a.


J.B.C.

H. Cameron.

Sunderland.

	STERN FRAME. <u>Post</u>	RUDDER FRAME.	STEM.
Material* - - - -	<u>Scrap Iron</u>	<u>Scrap Iron</u>	
W made - - - -	<u>Faged</u>	<u>Faged</u>	
Dimensions - - - -	<u>4 1/4 x 2 3/8"</u>	<u>5"</u>	
Progress on Inspection -	<u>Faged & smithed</u>	<u>Faged & smithed</u>	
When Inspected	<u>July 1-9-12-16-22-30</u> <u>Augt 2/84</u>	<u>Augt 2-6-9-13-18-25-29</u> <u>Sept 6-12-15/84</u>	

SKETCHES OF FRAMES SHEWING POSITION AND DESCRIPTION OF WELDS OF FORGINGS, OR PARTICULARS OF TESTS APPLIED TO CASTINGS.

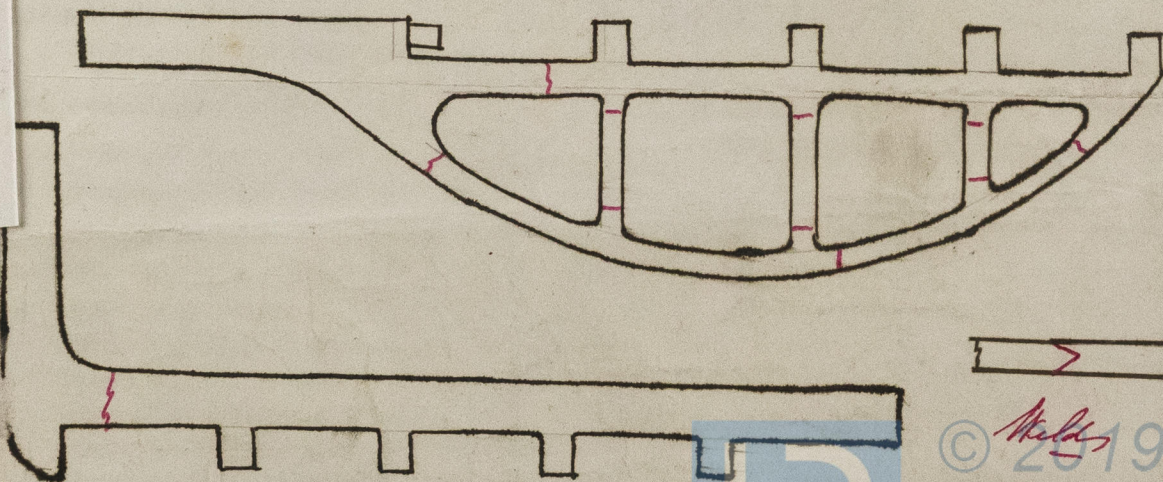

[T-1000—Mar./84—Trans. Ink.]

* If of Iron, state whether scrap or puddled Iron.

Manufacturer's name or trade mark,

The above is a correct description,

Stockton Malleable Iron Co.

BR882-0064

Lloyd's Register Foundation

H. M. Williams