






Hull Report Nos.:-

8328

+

8404

Ans 5440

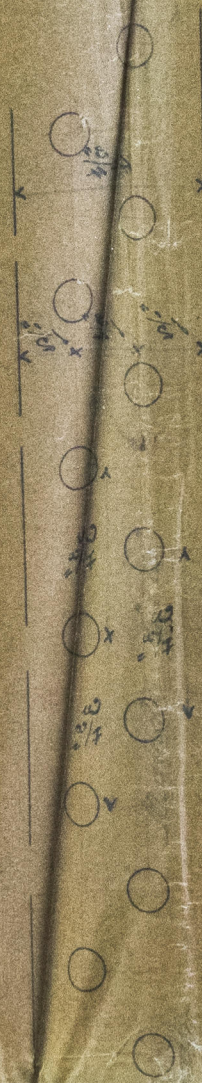

Plan of position of holes

Spaced 1 inch

Spaced 2 1/2 inch



© 2019

Lloyd's Register Foundation