

Midship Section Steel Screw Plug.

• Go Class 4.1 at Lloyd's for towing purposes.


## Dimensions

Length 67' 6" breadth 15' 9" depth hold 8' 2"

Scale  $\frac{3}{8}'' = 1 \text{ foot.}$

JOSEPH CONSTANT,  
22, MILLER STREET,  
LONDON E.C.

18. Feby 1892

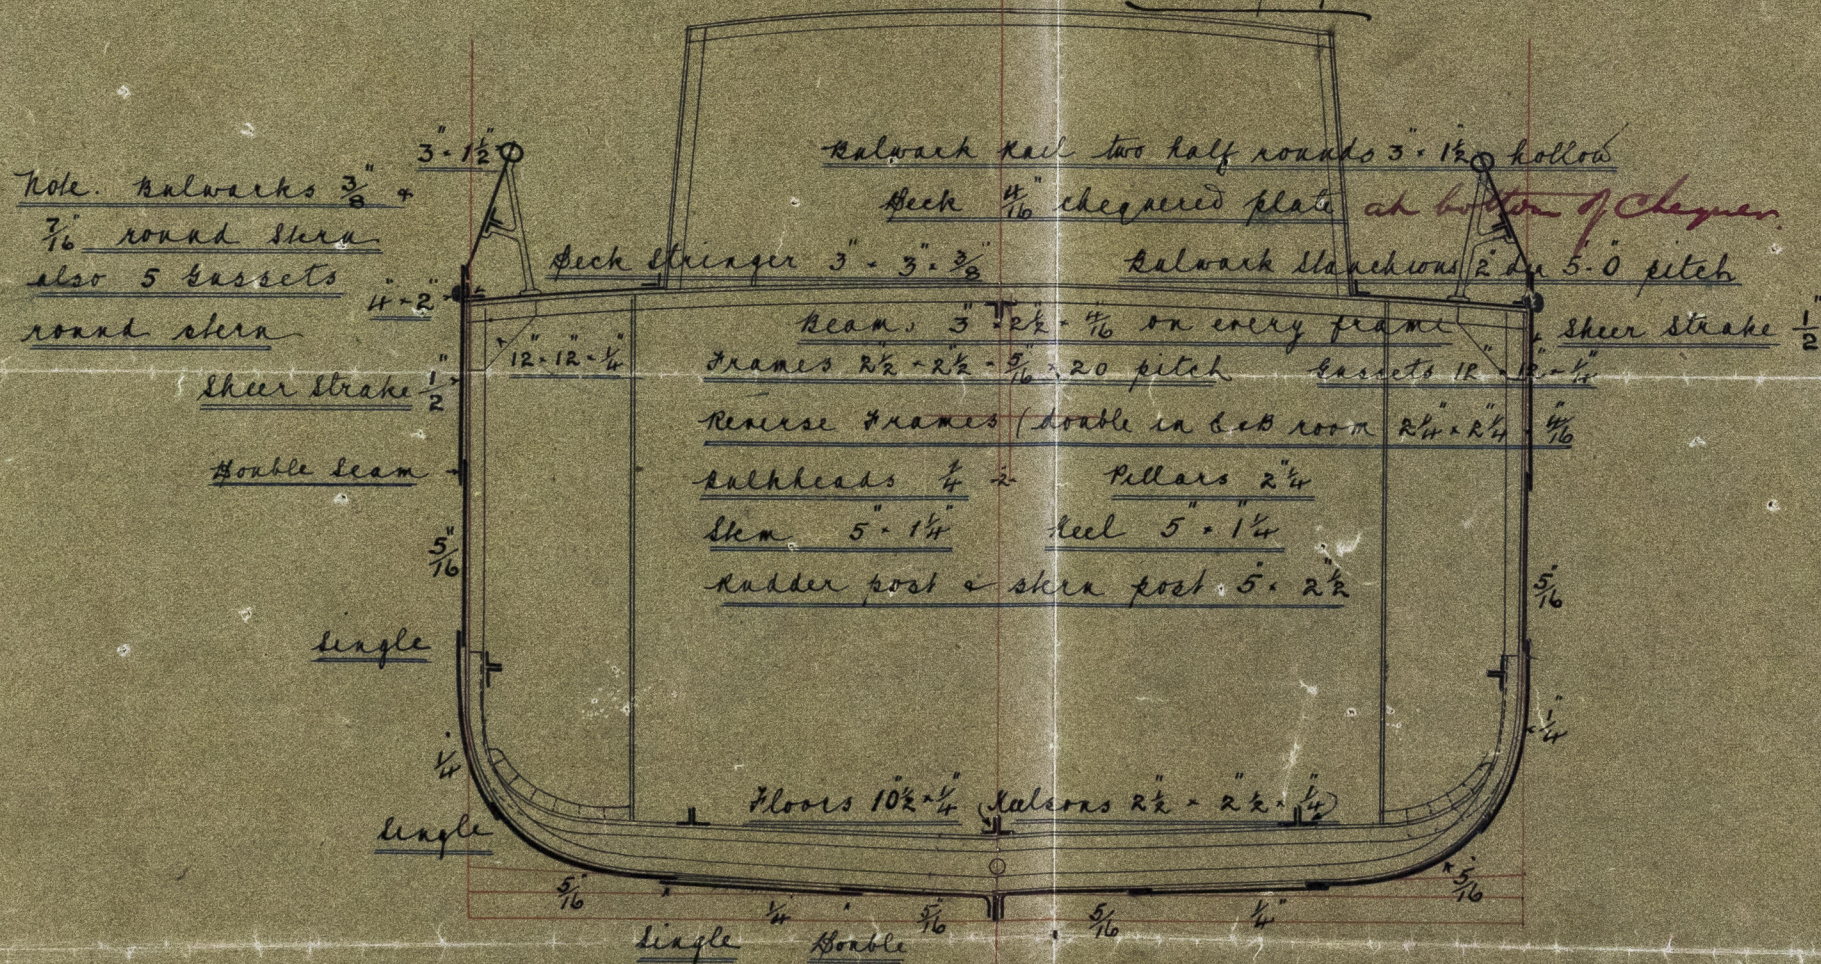

Kalwack nail two half rounds 3"  $1\frac{1}{2}$  hollow

Beck  $\frac{4}{16}$ " chequered plate at bottom of Chequer

Deck stringer  $3" \times 3" \times \frac{3}{8}"$

Bulwark Slanchions 2' to 5'-0" pitch

Beam:  $3 \times 2\frac{1}{2} \times \frac{4}{16}$  on every frame

Frames  $2\frac{1}{2} - 2\frac{1}{2} - \frac{5}{16} \times 20$  pitch      Cassets 12" 12" - 4"

Reverse frames (double in B&B room  $2\frac{1}{4}'' \times 2\frac{1}{4}''$ )

bulbheads  $\frac{1}{4}$  2 Pillars  $2\frac{1}{4}$

stem  $5 \times 1\frac{1}{4}$  heel  $5 \times 1\frac{1}{4}$

Rudder post & stern post 5' 2 $\frac{1}{2}$ "

Floors  $10\frac{1}{2} \times \frac{1}{4}$  (Kitchens  $2\frac{1}{2} \times 2\frac{1}{2} \times \frac{1}{4}$ )

Ross plates + plates above + below same  $\frac{5}{16}$


Calfit to Lloyd's rules

© 2019 Lloyd's Register Foundation



Midship Sec.  
"Bee"

Brs.  
"M59" "Bis Rant" 555.  
5540

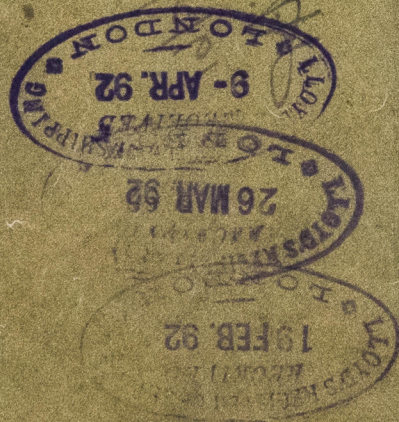





2019

Byd's Register  
Foundation