
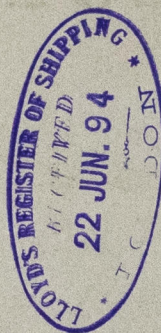
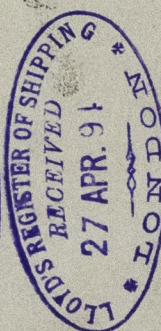


29. 3. 94
10. 4. 94
27. 4. 94

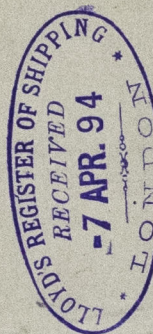

"Kate and Annie," Bristol Report - M
5965.

Length from fore part of stem to after part of stem post 83 feet
Main breadth 21 feet
Depth of hold $2\frac{1}{2}$ feet
9' 3" $15 + 2\frac{1}{2}$ depth

Deck. $5 \times 2\frac{1}{2}$

English Oak Beams Sides of Trussed 8" in middle & 6" at ends

all English Oak Frame, Timbers & Space 18".
 Parallel floors sided 6" moulded 8" at keel
 First futtocks sided 8" moulded at floor head 6"
 2nd " " 5 1/2"
 3rd " " 5 1/2" moulded at head 4 1/2"
 4th " " 5 1/2"

~~Spains of Long in hanging~~
knee rides
5 Pairs only.



See letter 10/4/94

9 years Table A
~~12 years~~
 A ~~1~~ ~~years~~ selling
 X ~~1~~ ~~years~~ metal fastening
 12 A
 9 + 12 yrs mat, ~~XXX~~ cf

$3\frac{1}{2}$ + 4 blocks

6. 6
11 + 6

etch bene

Med. 6

Maxil.
Sed.

Pitch pens 2 1/2 shil

Ridge $3\frac{1}{2}$ thick


E. Lee.

2 Nov 1944

2. Elm $8 + 2\frac{1}{2}$

Scale one inch = one foot



© 2019

Lloyd's Register
Foundation