

*A. L. Lloyd*  
Lloyd's Register of British and Foreign Shipping.

(Received in the London Office,)



P.

No. 33

## REPORT ON SHIP FORGINGS.

Sir,

I beg leave to report that the undermentioned Forgings, manufactured by  
*The Barrow Ship Bldg Co. Ltd of Barrow*  
for the Vessel No. *152*, being built by *same firm*  
of *—* have been inspected by me in course  
of being forged and smithed, and found to be, so far as can be seen, *Satisfactory.*

Mark on Forging.

Lloyd's

No. 33

*DR. 11-86*

The Secretary,  
London.

I am, Sir,



Your Obedient Servant,

*P. Ritche*

*Barrow.*

	STERN FRAMES.	RUDDER FRAMES.	STEMS.
Material*	<i>Scrap Iron</i>	<i>Scrap Iron</i>	<i>Scrap Iron</i>
How made	<i>Forged</i>	<i>Forged</i>	<i>Forged</i>
Dimensions	<i>6 x 2 5/8</i>	<i>5 1/4 Dia</i>	<i>6 x 2</i>
Progress on Inspection	<i>Forging &amp; Finished</i>	<i>Forging &amp; Machining</i>	<i>When Forged</i>
Dates when Inspected	<i>5/8-9, 22/9/86</i>	<i>5/8, 22/9, 25/11/86</i>	<i>5/8-3/9, 22/9/86</i>

SKETCHES OF FRAMES SHEWING POSITION AND DESCRIPTION OF WELDS.

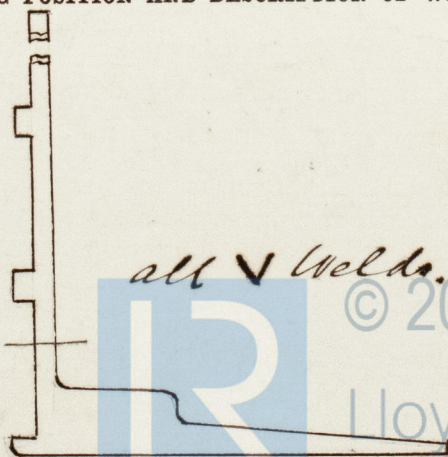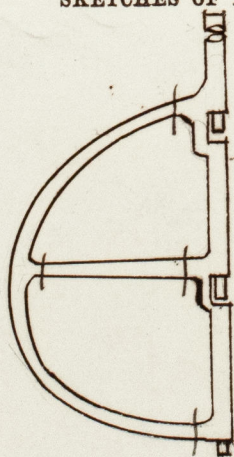

*all V Welds.*