

Lk: 28/3/87

Bazelgate Bred ref 143



T. S. S. No 152

PUMPING ARRANGEMENT

SCALE 1/4" = 1 FOOT.



M
25.5.87

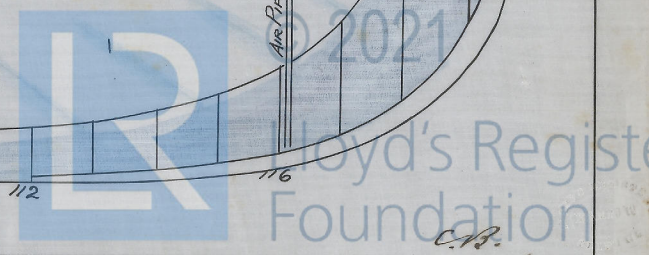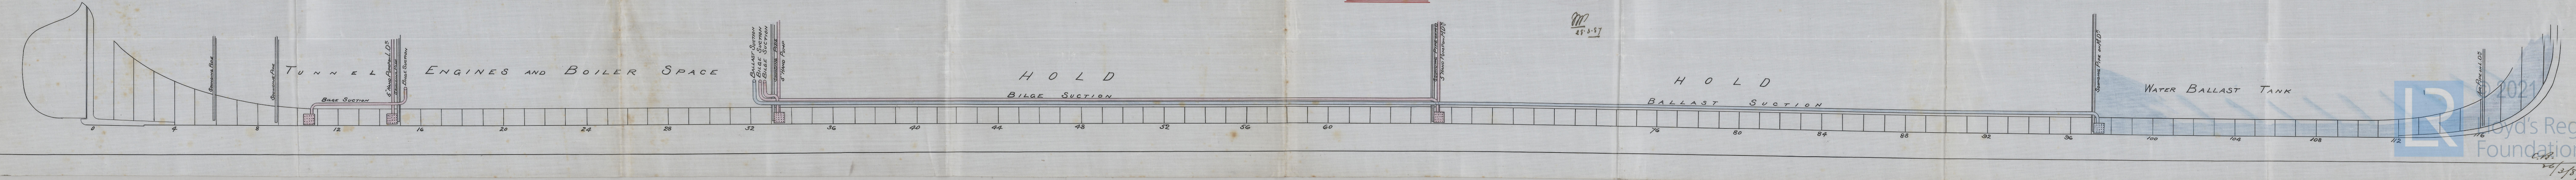

26/3/87

44


48

25

20



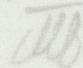


SCALE $\frac{1}{4}'' = 1 \text{ FOOT}$

PUMPING ARRANGEMENT

1 S. S. No 152



© 2021

Lloyd's Register
 Foundation