


L.C.C. S.S. 'BAZALGETTE'. PART DECK PLAN.

Sketch of test holes in deck plates. Oct. 1919.

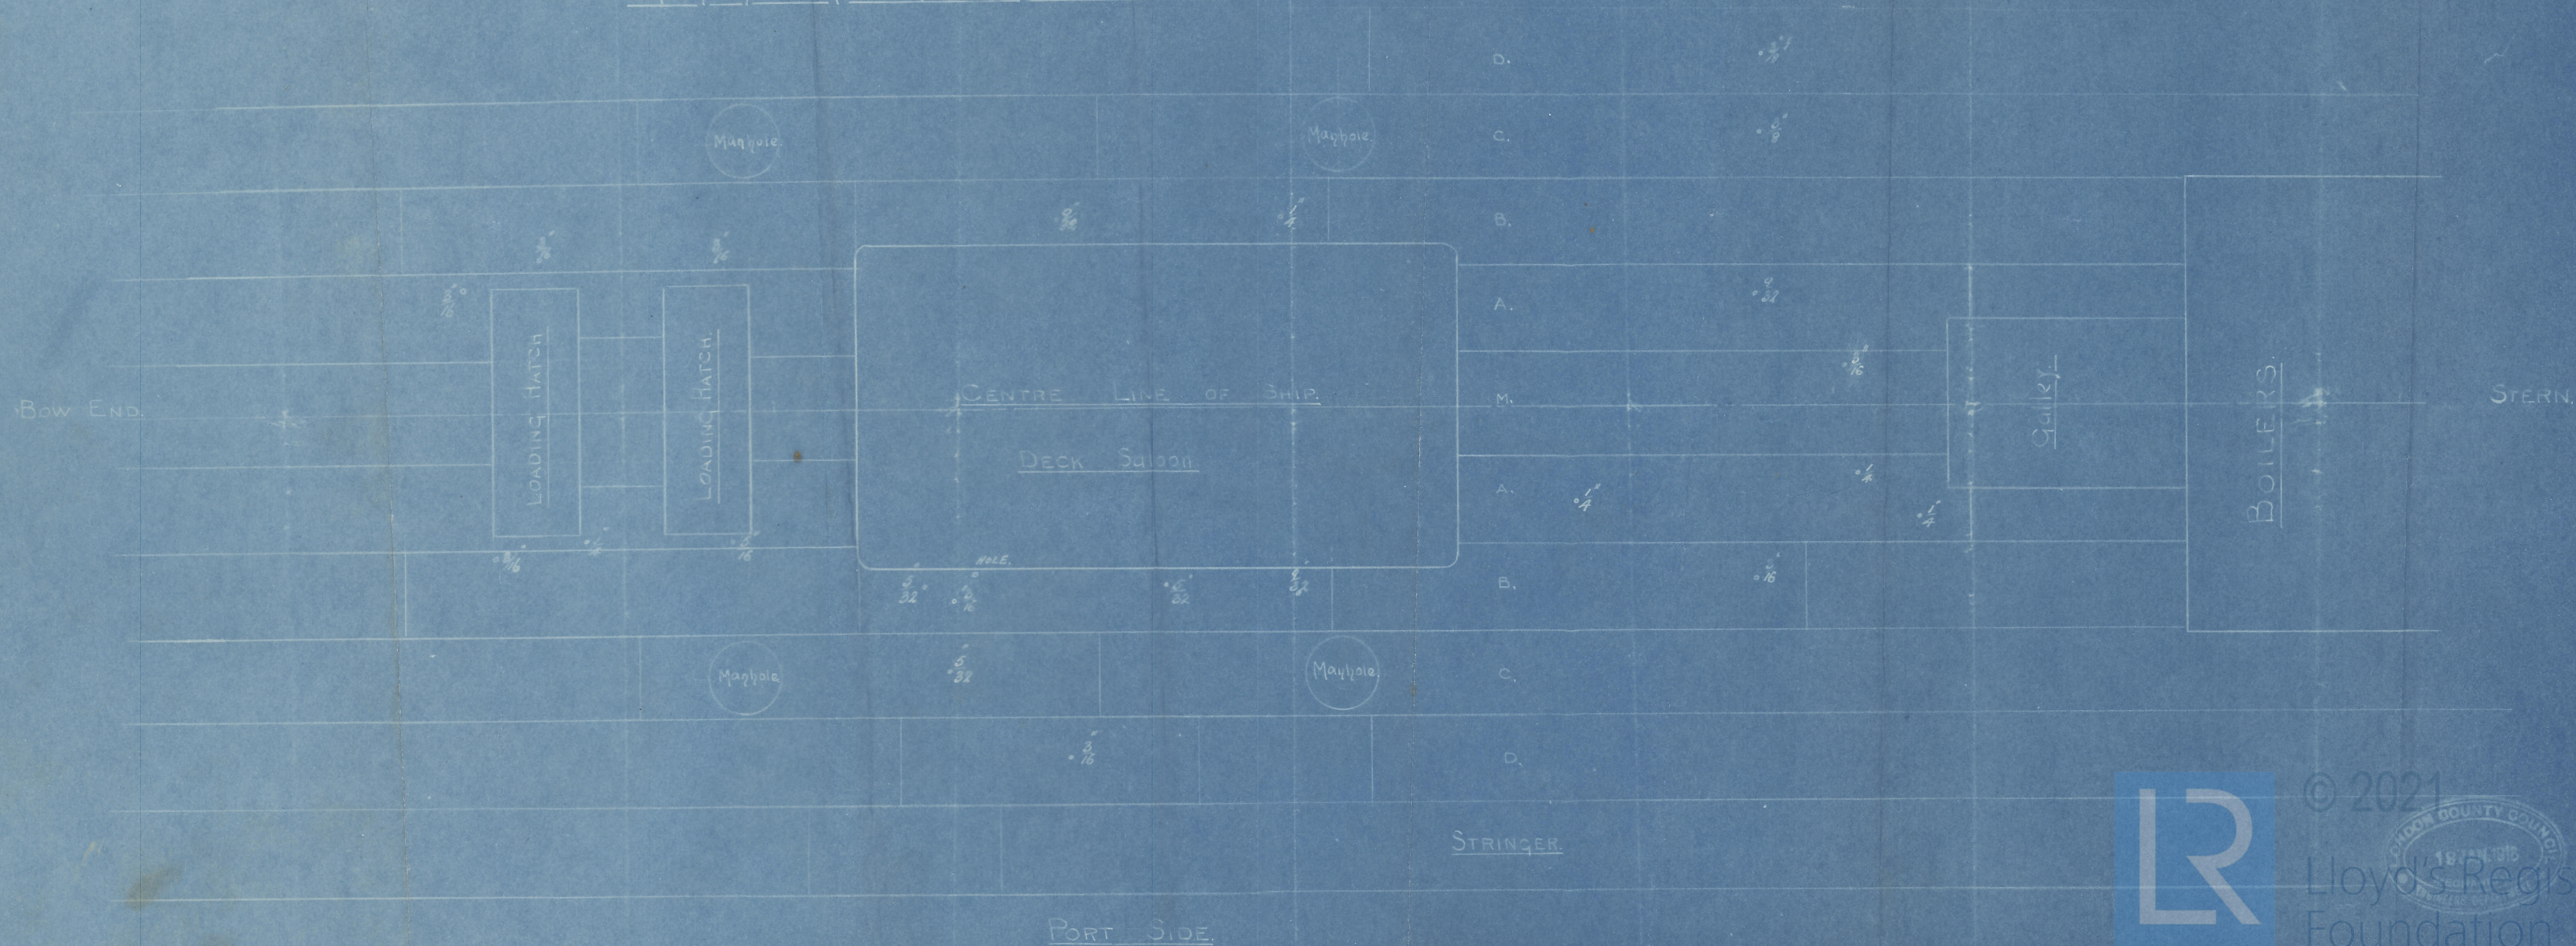

W. "Bayalgette"

Lon Rpt No. 82621



© 2021

Lloyd's Register
Foundation