


Tracing 595
March 14-1891

20.3.91.


PROPOSED ALTERATION TO SS "SCALE FORCE" (now named "Holme Wood") Mm. Rep. No. 4044.

SCALE $\frac{1}{4}$ " = 1 FOOT

ALTERATIONS TO BE MADE AS SHOWN IN RED

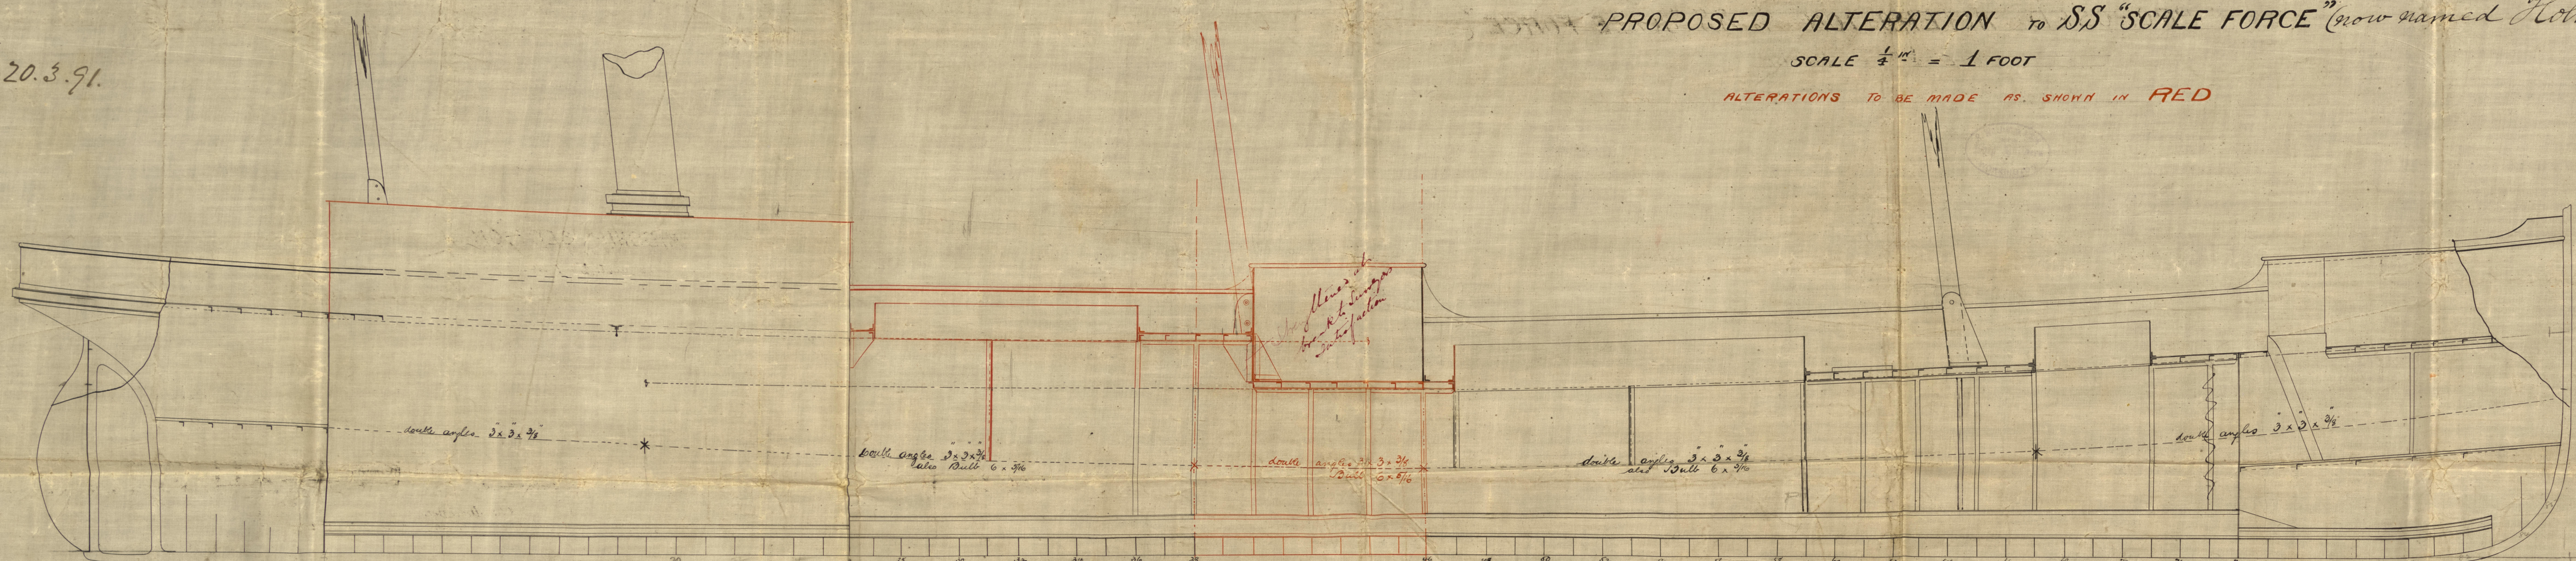


Lengthened 13'-5 1/2" - 3 ft

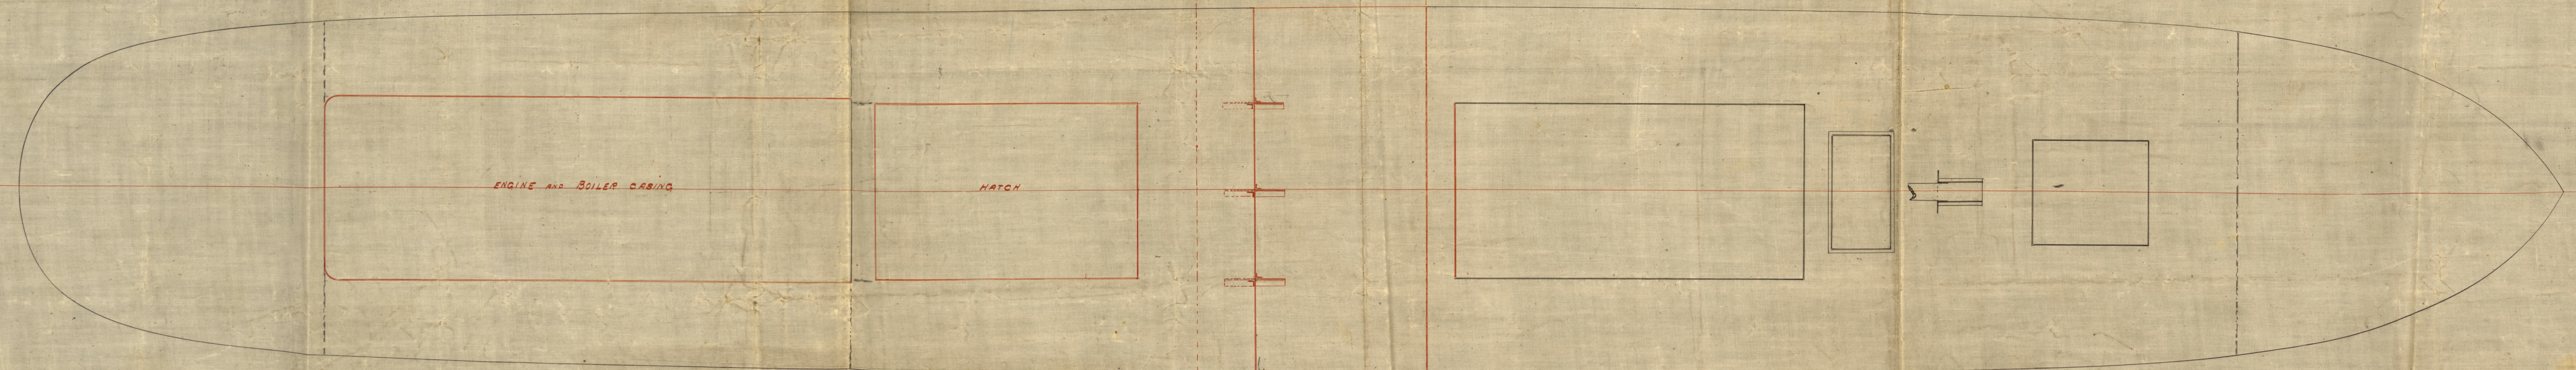

MIDSHIP SECTION

SCALE $\frac{1}{4}$ " = 1 FOOT

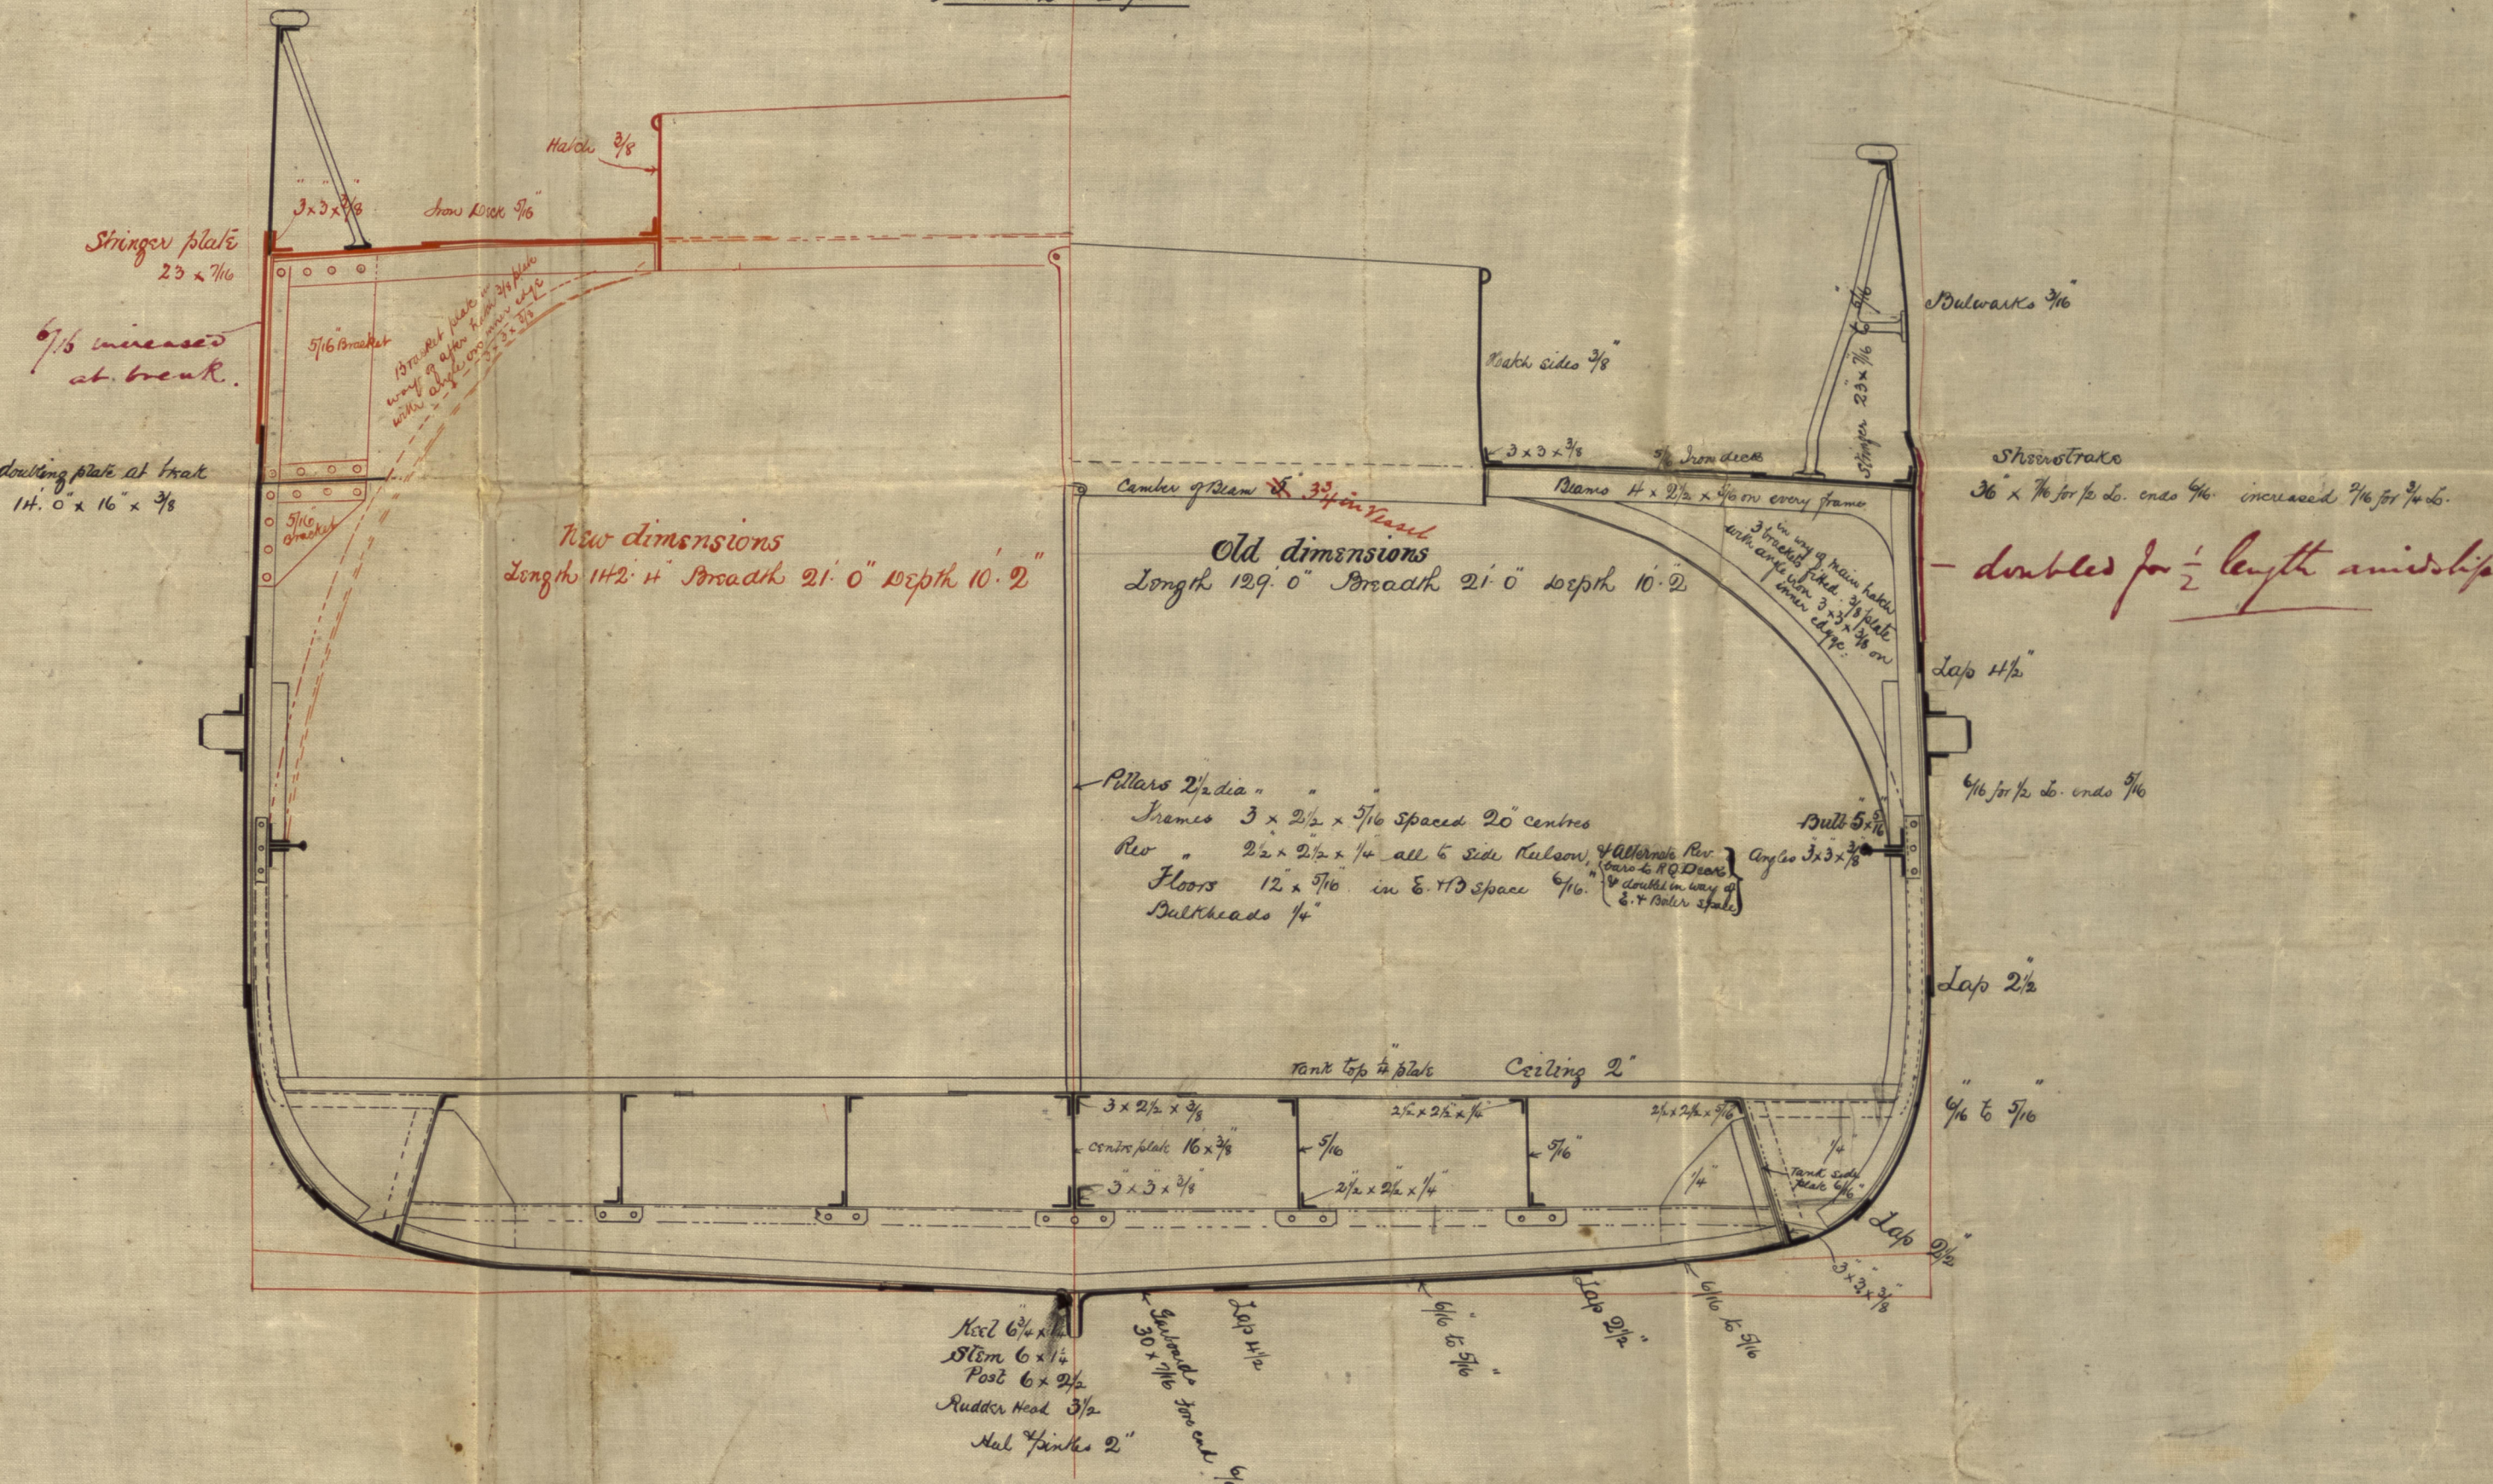


4 168
337

1891-1892
1891-1892

SS "Holme Wood"
ex
"Seale Force"

1891-1892

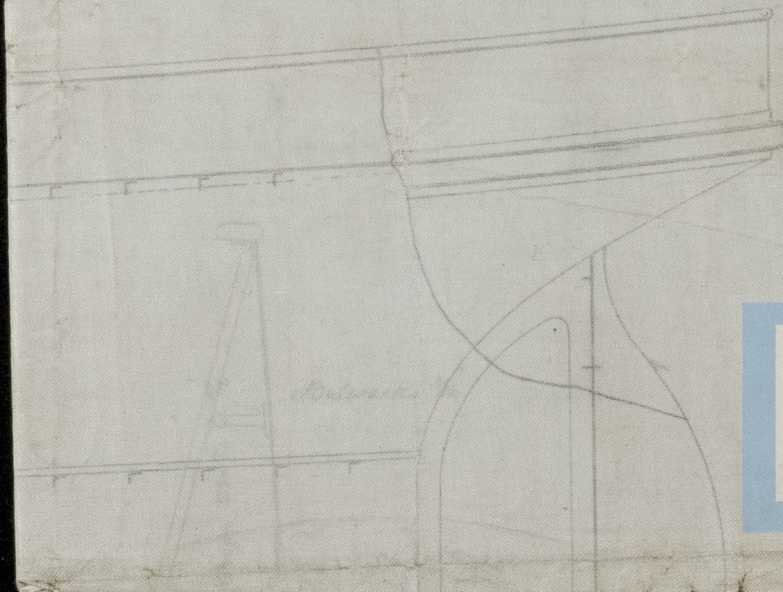

© 2021

Lloyd's Register
Foundation