Ltr: to Brw: 21:10:91

T.S.S. No 201. 211 + 212

21.11.91.

ARRANGEMENT OF BALLAST & BILGE PIPES.

SCALE 1/8 INCH — ONE FOOT.

No. 201. S/s Bennie
Brw. Rpt. No. 429.

Brw. 17-10-91.

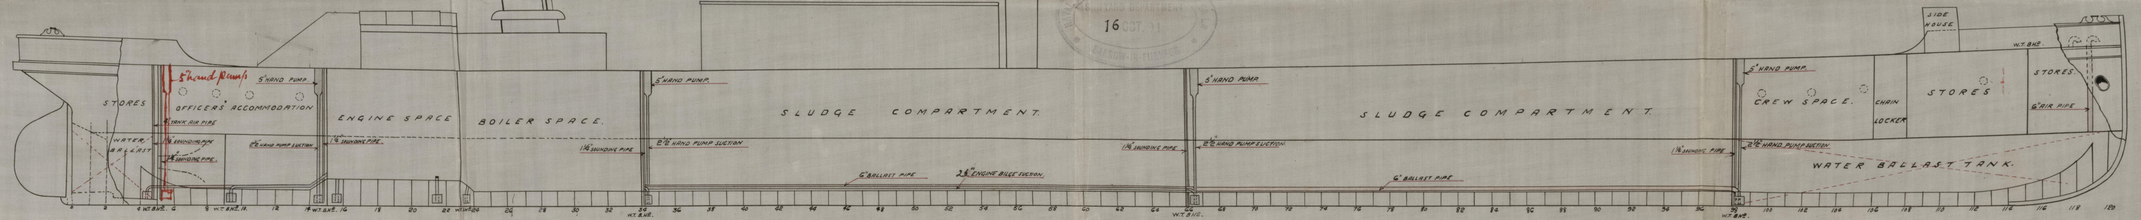

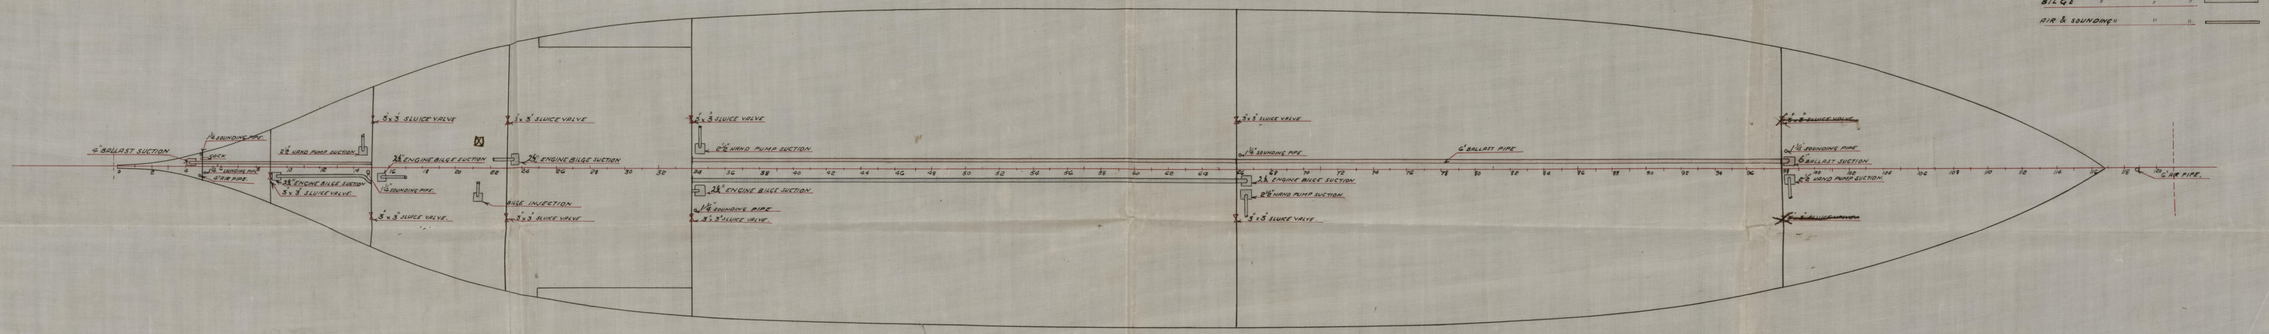

© 2021 Lloyd's Register Foundation