

31. 3. 92.

31 MAR 92

S.S. No 215.


22

Brw
30/3/92
H.L.

SECTION SHEWING AMENDED ARRANGEMENT OF CENTRE KEELSON

FORWARD OF OIL COMPARTMENT.


SCALE 1/2 INCH = ONE FOOT.

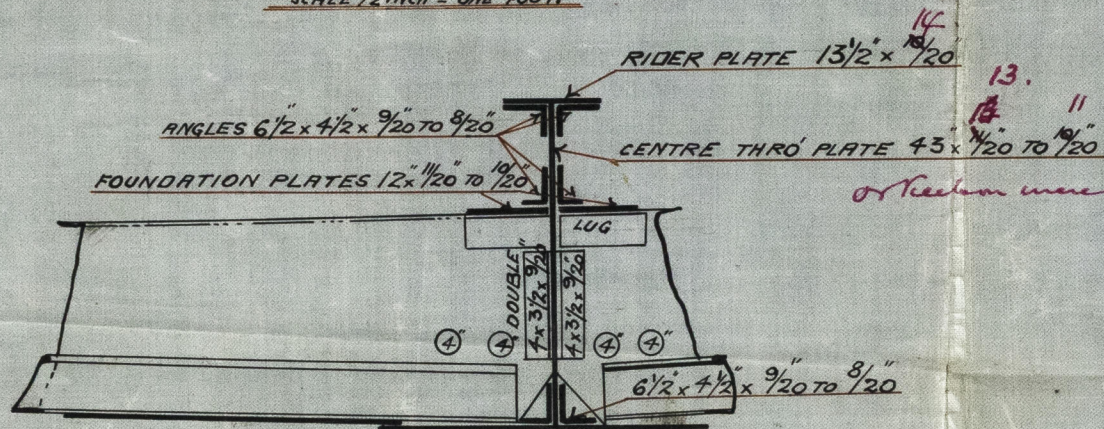

PROPOSED ARRANGEMENT OF BULKHEAD LINERS

IN WAY OF OIL COMPARTMENT.

SCALE ONE INCH = ONE FOOT.

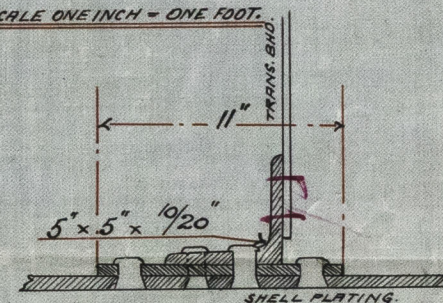

© 2019

Lloyd's Register
Foundation

BRW42-0008

Northern Light
Brew 494

BW42-0008

30/1/82
11/2

22

8/8

10

12

213 913 2









 


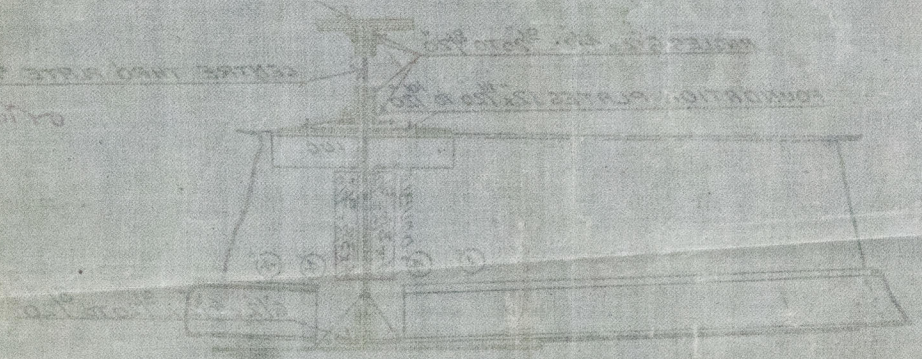

© 2019

Lloyd's Register
Foundation