


S.S. "Northern Light".

Stiru Post.

Scale 1/2" = one foot.

Cast Steel.

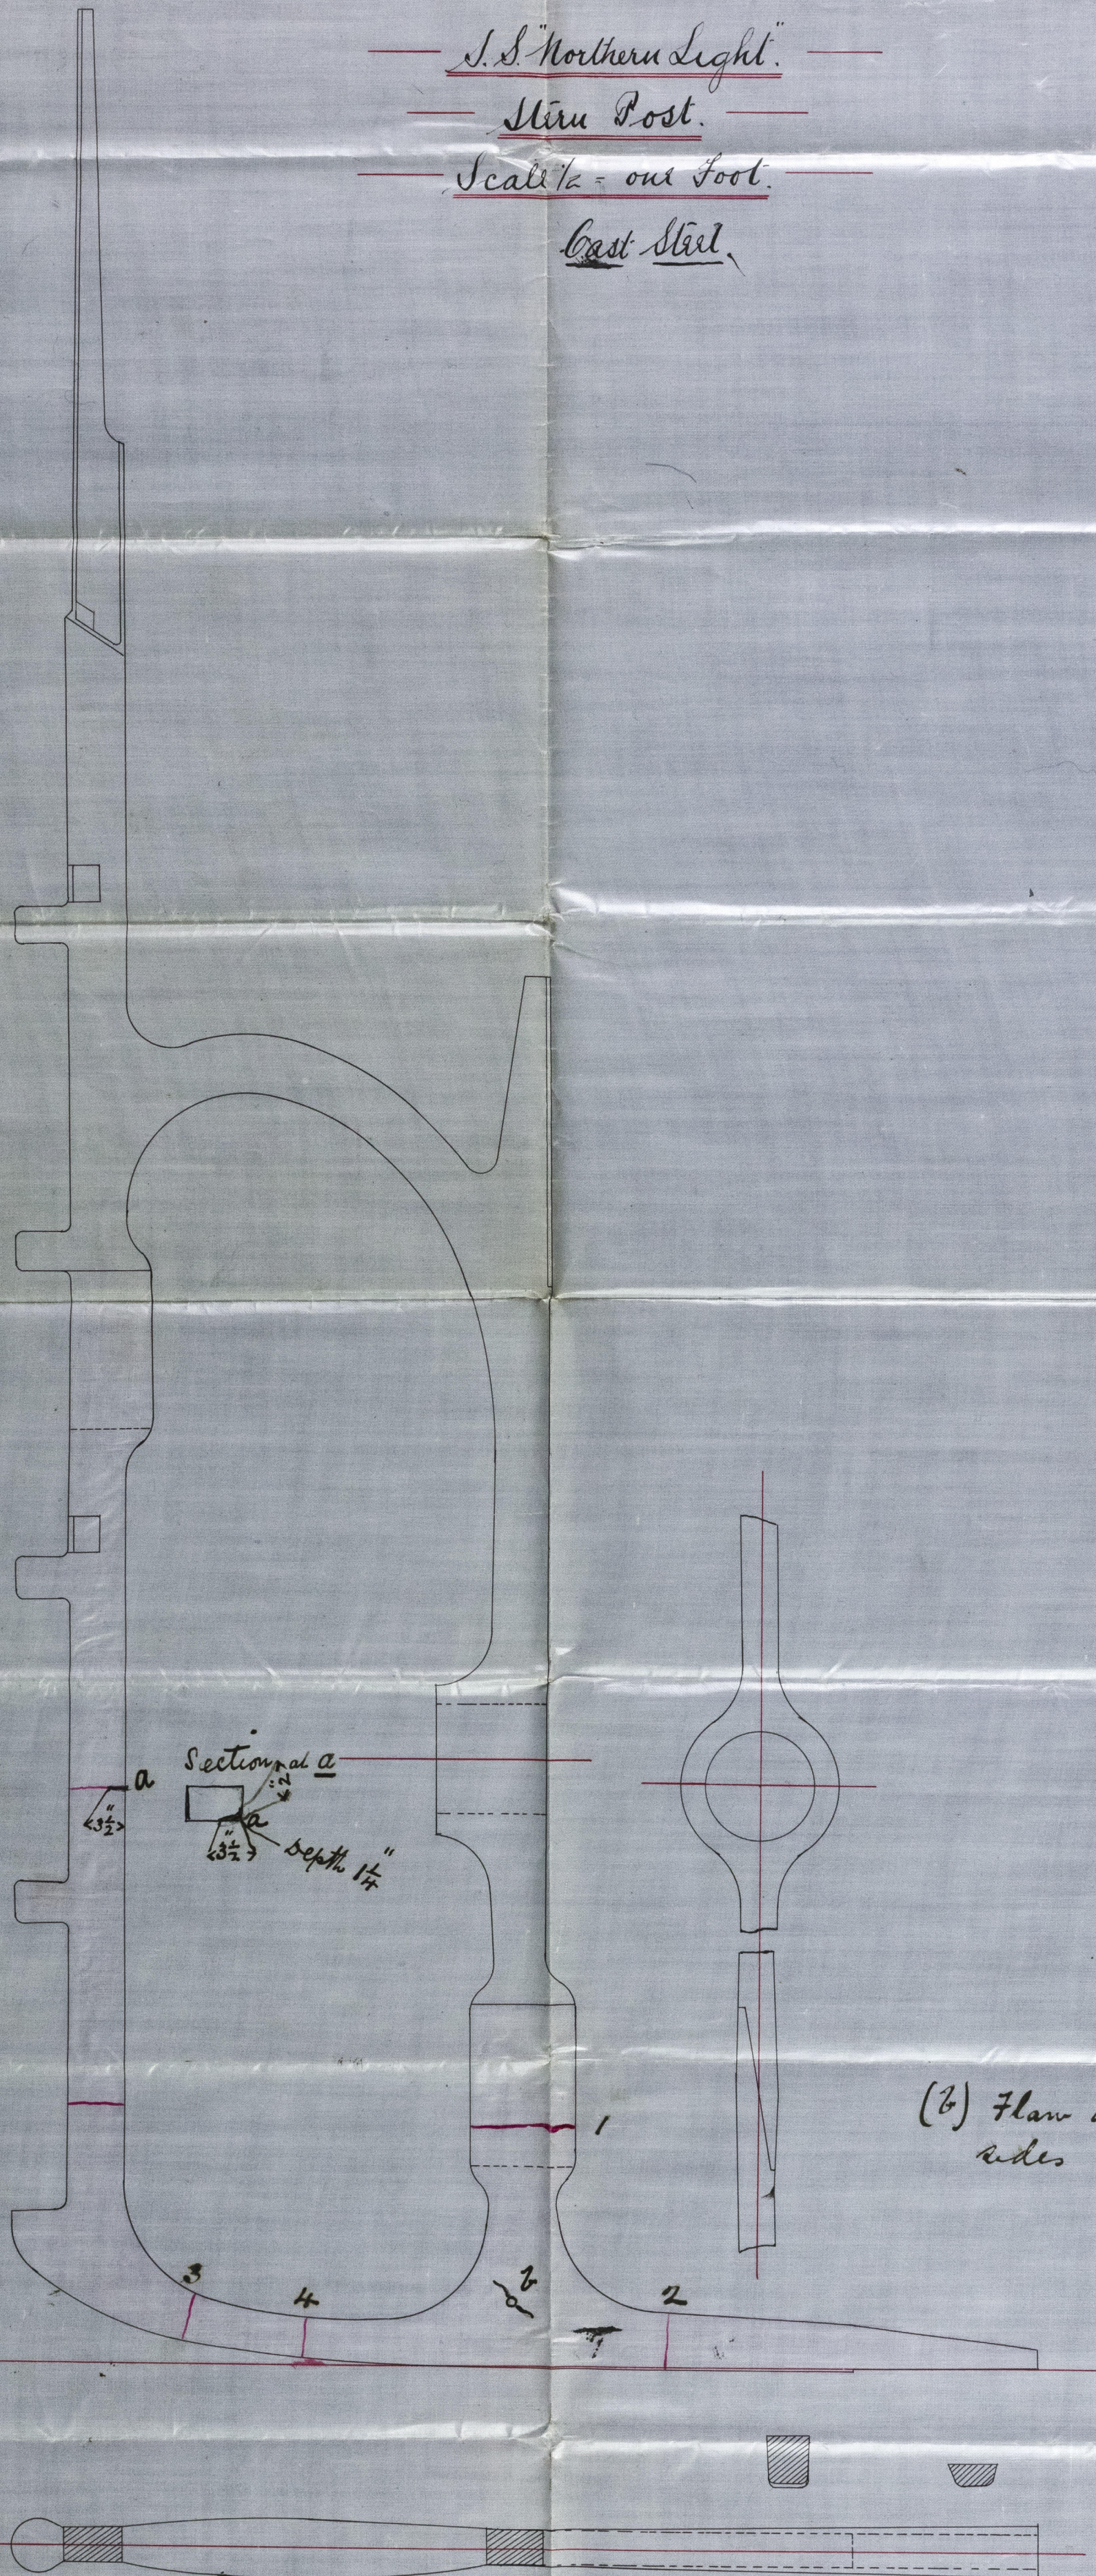



BRW 42-0024



(2) 4 1/2" x 1 1/2" x 1/4"



© 2019

Lloyd's Register
Foundation