

Ex. 14. 9. 92.



S/S "Northern Light"  
Bris. Rpl. N. 497

Bris 8/9/92.

S.S. No. 215.

OIL & BALLAST PIPING ARRANGEMENT

SCALE 1/8 INCH = ONE FOOT.

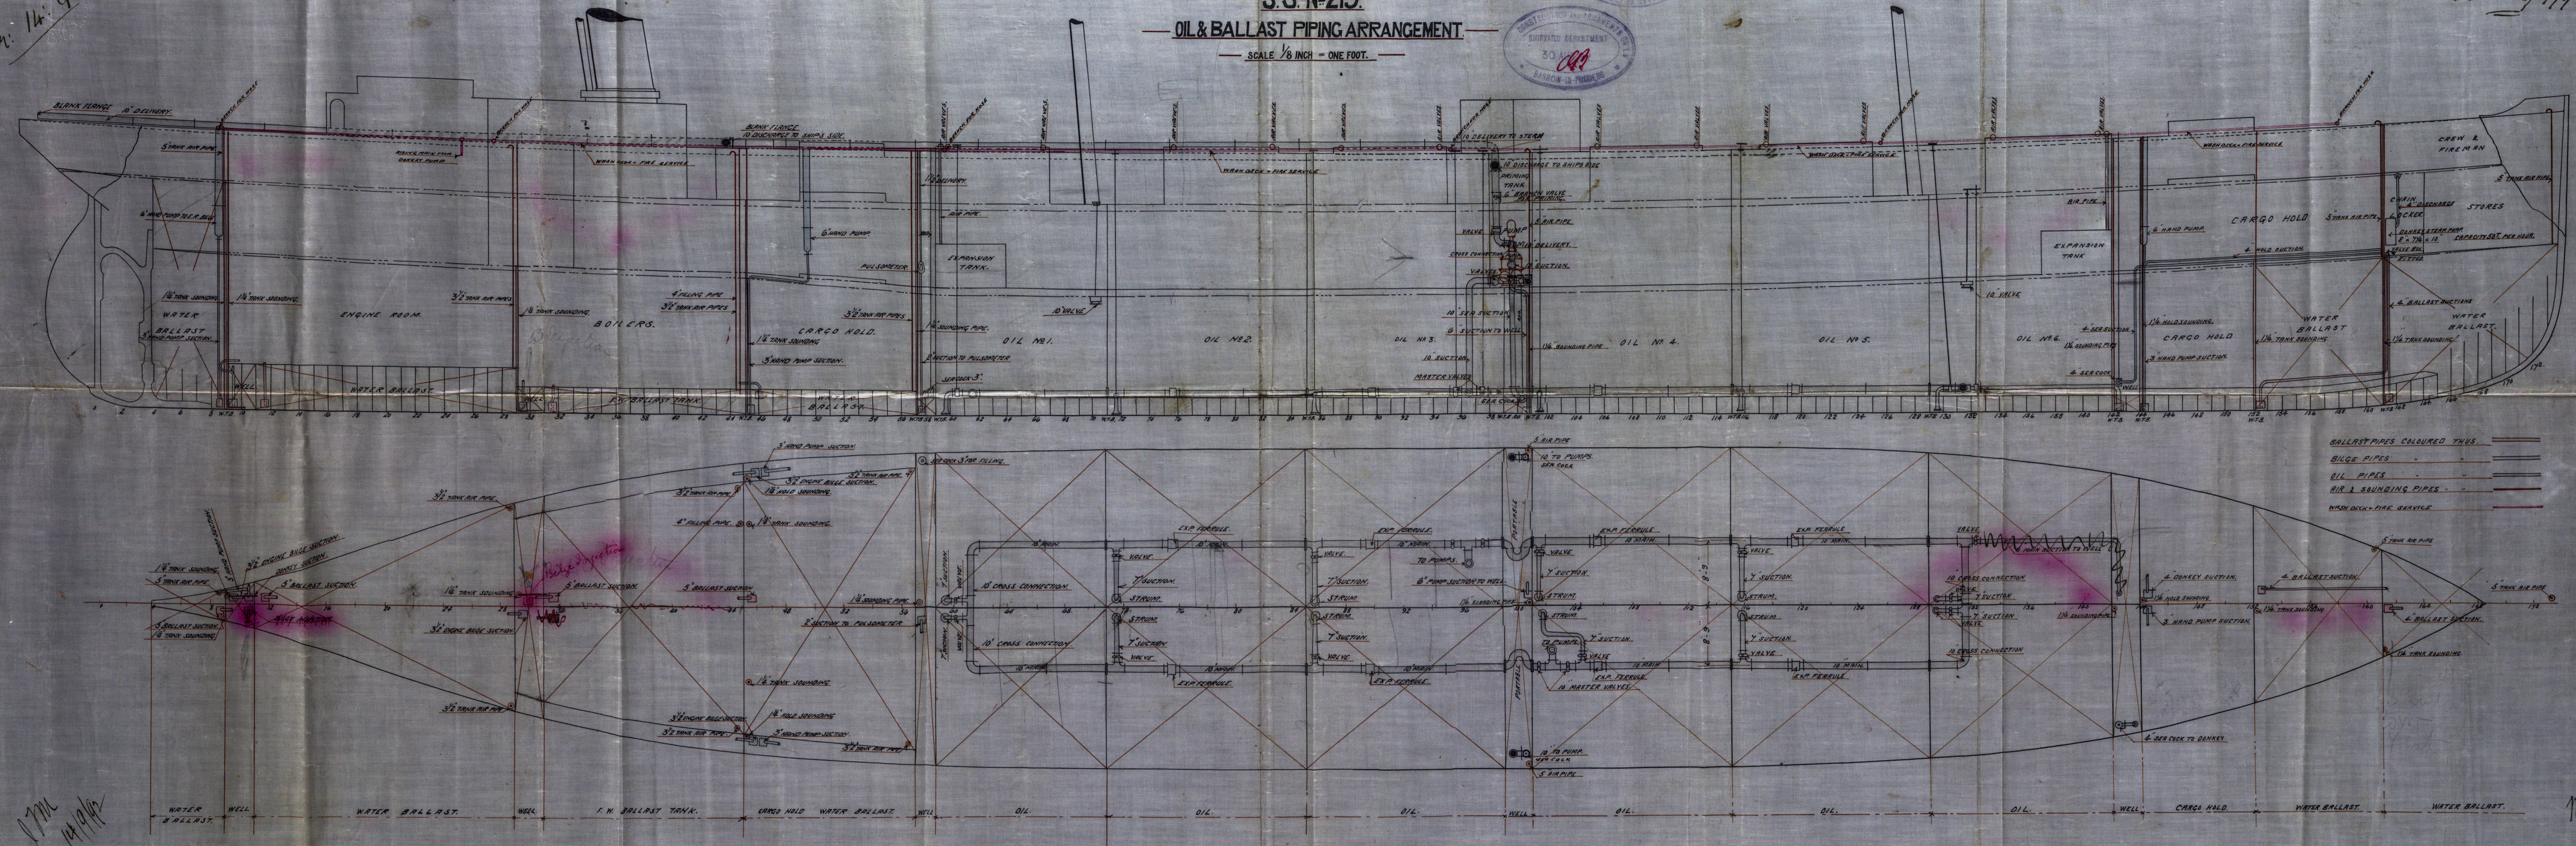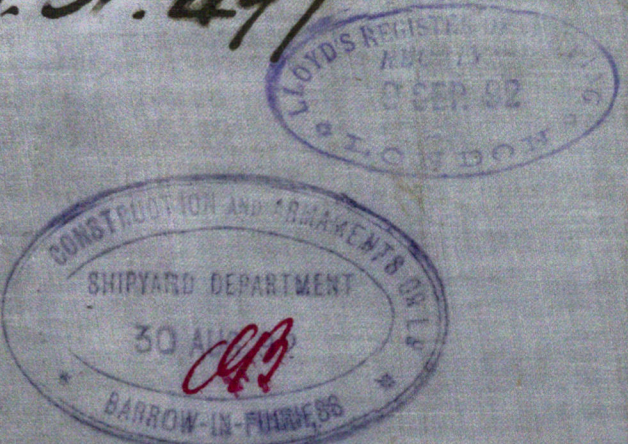

- BALLAST PIPES COLOURED THUS: ———
- BILGE PIPES ———
- OIL PIPES ———
- AIR & SOUNDING PIPES ———
- WASH DECK FIRE SERVICE ———

SM 14/9/92

11/9/92