


Northern Light
 N. C. Am. Co. 215
 Oil Steamer.
 No 215.

SKETCH SHEWING ERECTIONS ON UPPER DECK, & OPENINGS — (as built)

SCALE 1/4" = ONE FOOT.

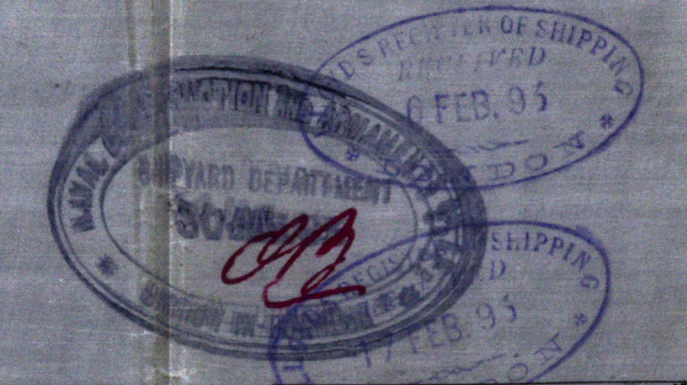

Drawn 4/24/95

