


"Northern Light" See later arrangement
for erections and openings

Brw Rpt No 492

H.C. Am Co. No 215.

ALTERNATE ARRANGEMENT OF FRAMING.
ABOVE UPPER DECK
SCALE 1/8" = 1 FOOT.

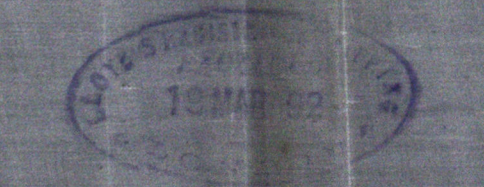

Brw
18/3/22
m.d.



* Butts of plating double riveted.

BRW 42-0040




Foundation

Handwritten in red ink:
Northern Light



Handwritten in black ink:
Northern Light
Brw 497

Handwritten in black ink:
R. G. W. Co.

Handwritten in black ink:
AFTERWARDS
NO. 1
22

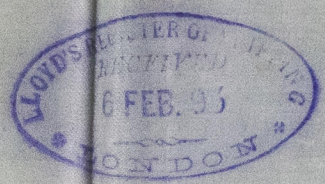

BRW42-0040

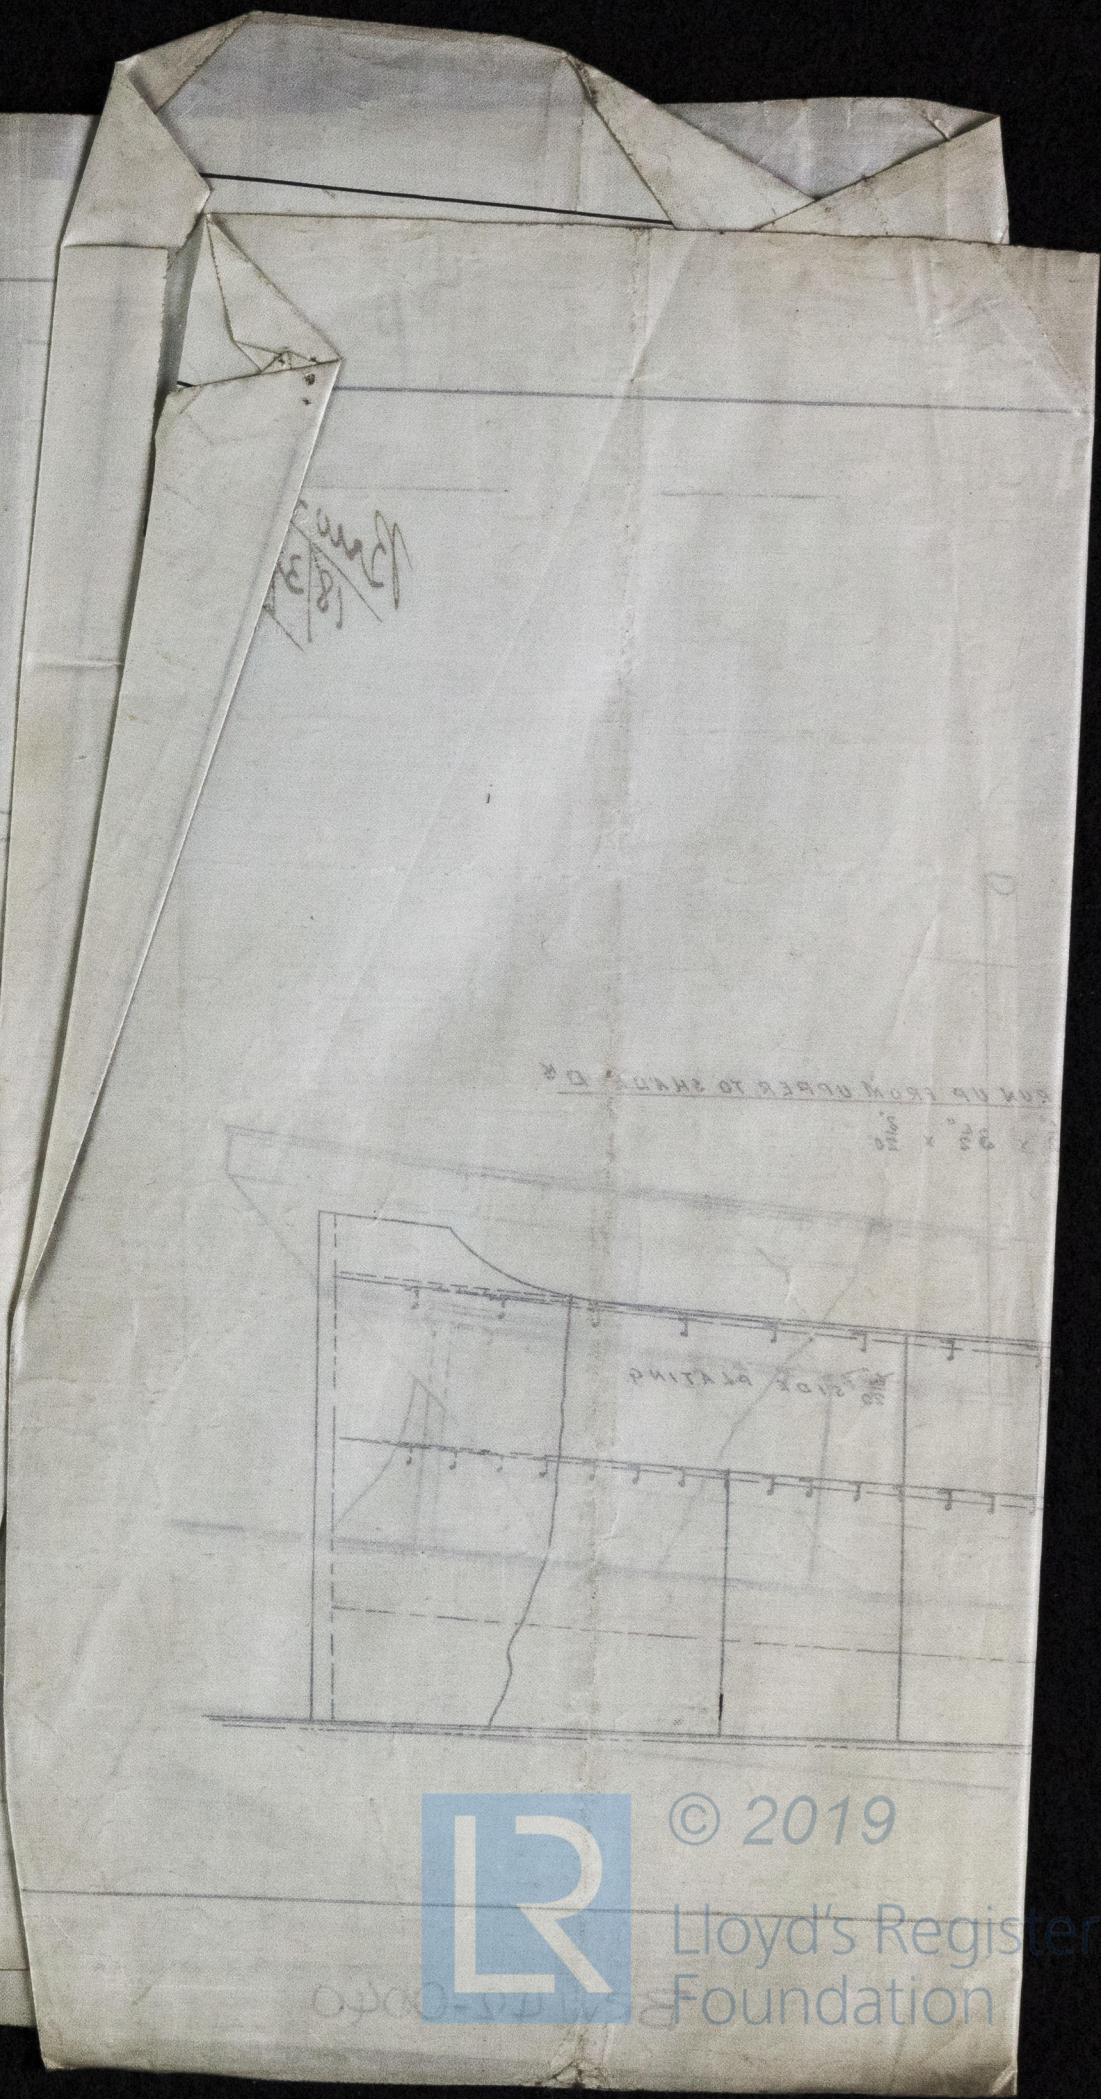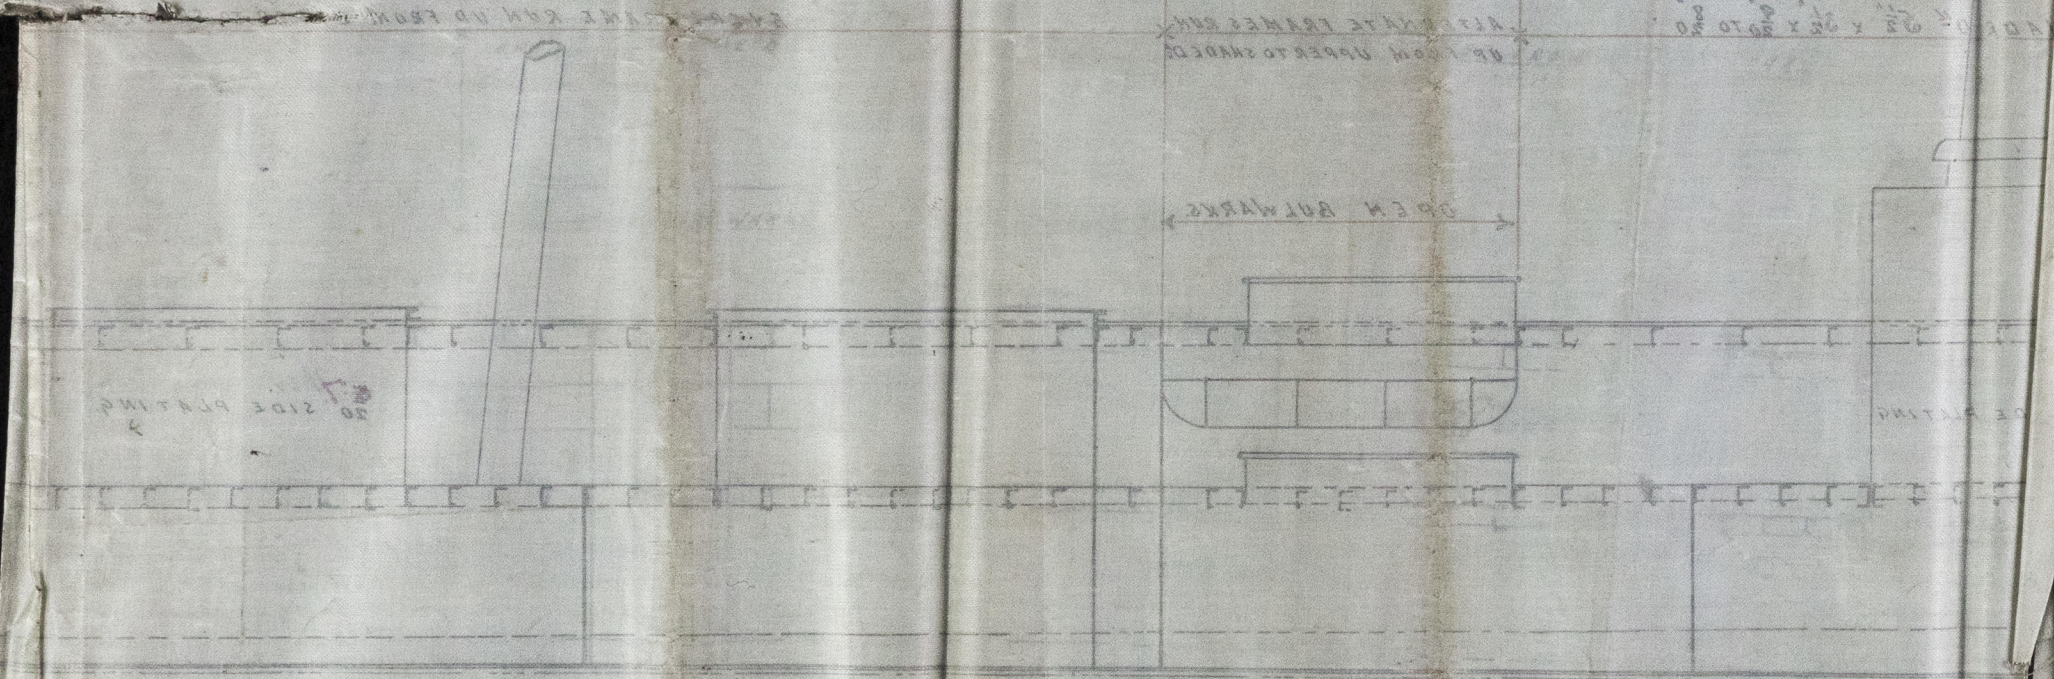

© 2019

Lloyd's Register
Foundation