

24.3.92
14.9.92

S/S "Northern Light"
Rev Rpt. No. 497.

19 MAR 92

Bru
10/3/92
M


No 15

CONSTRUCTION OF DOUBLE BOTTOM


SCALE 1" = 1 FOOT




SECTION AT No 11

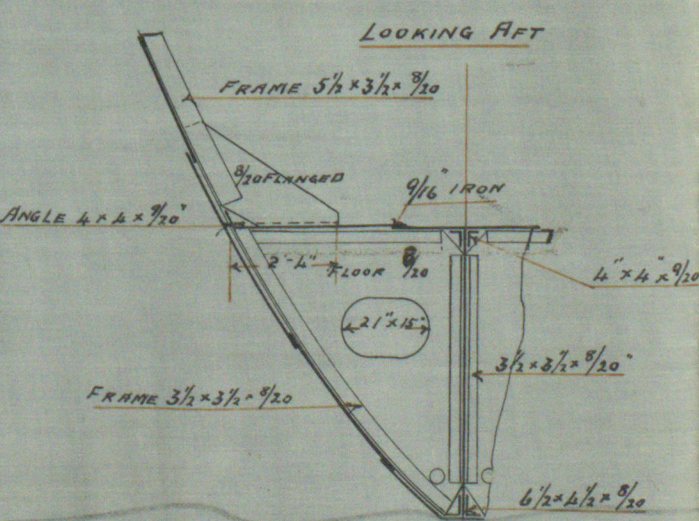


SECTION AT No 29 BULKHEAD

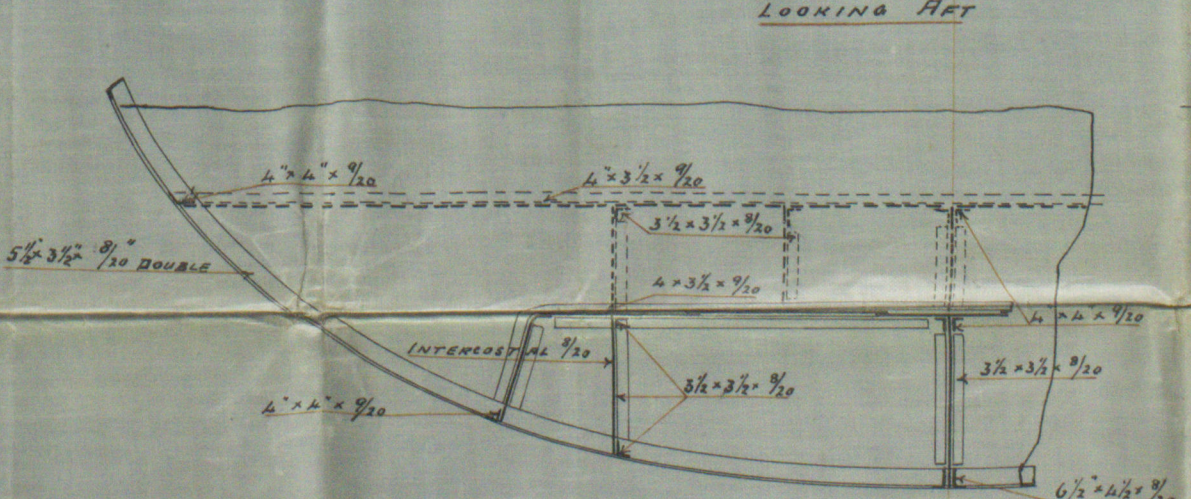


SECTION AT No 44

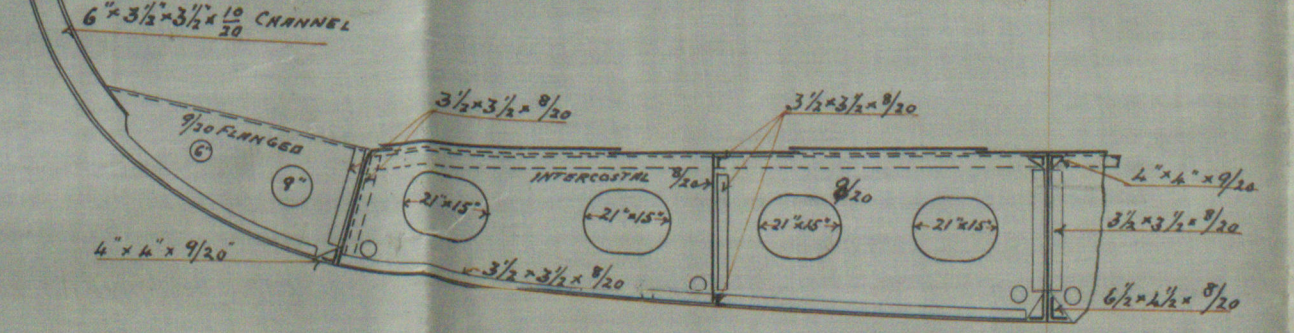


SECTION AT No 24

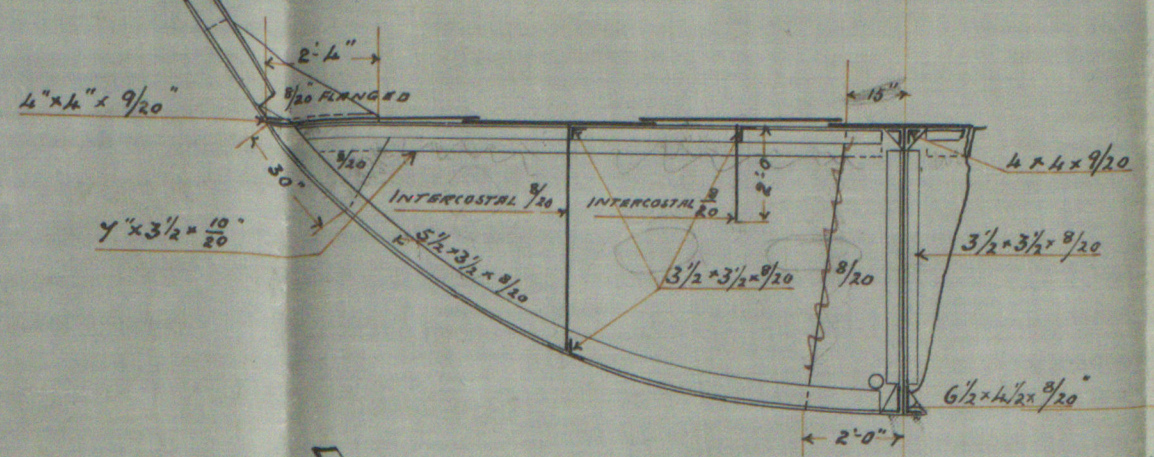

SECTION AT No 19

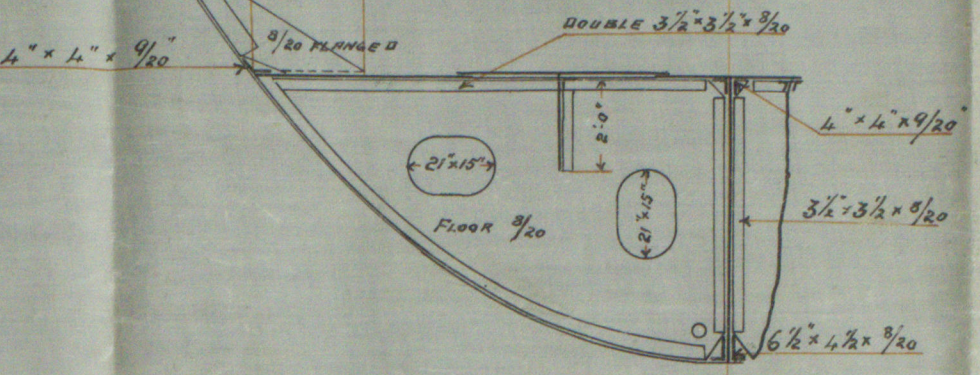


See letter
24/3/92

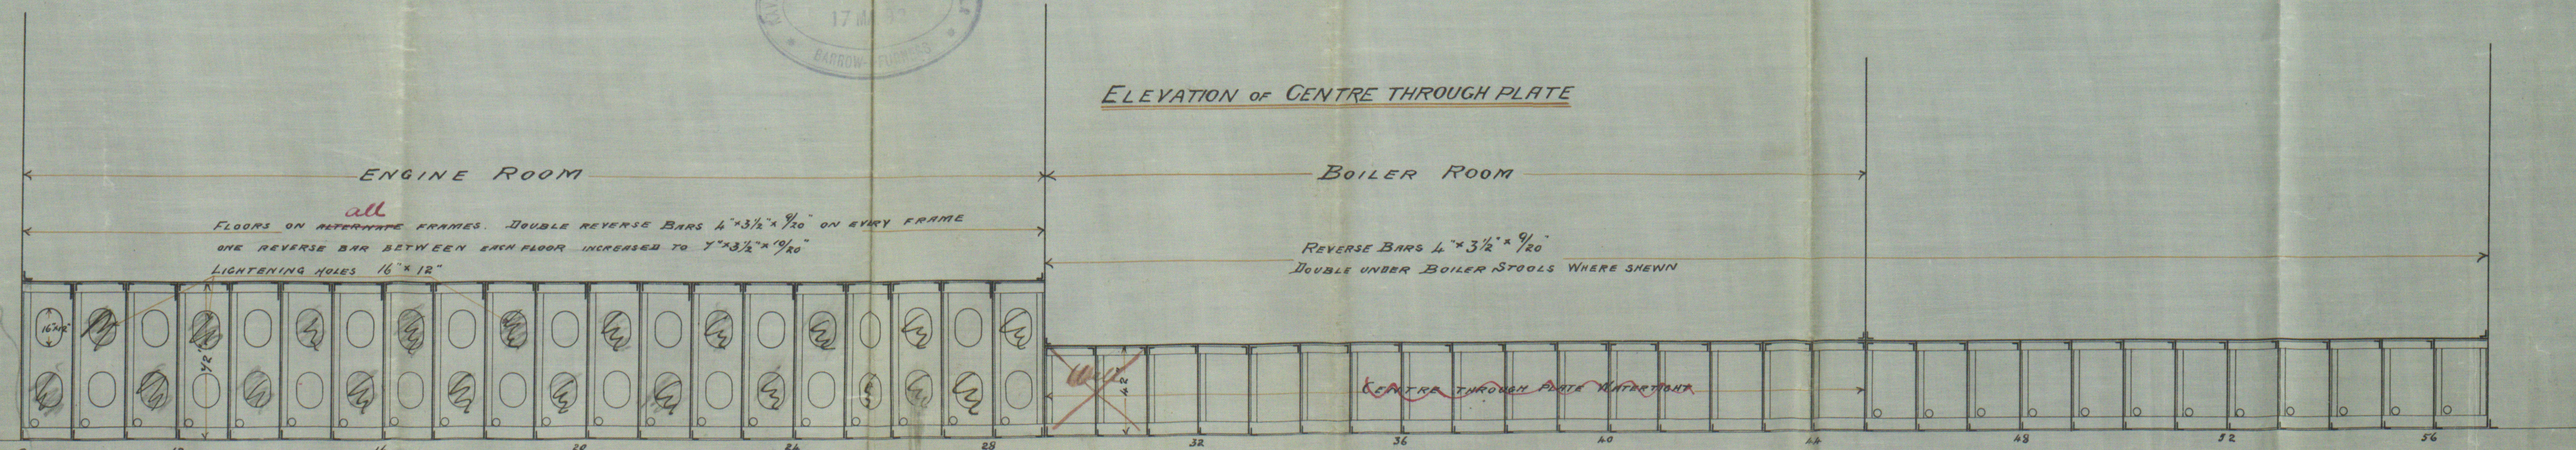

ENGINE ROOM

BOILER ROOM

ELEVATION OF LONGITUDINAL UNDER ENGINES

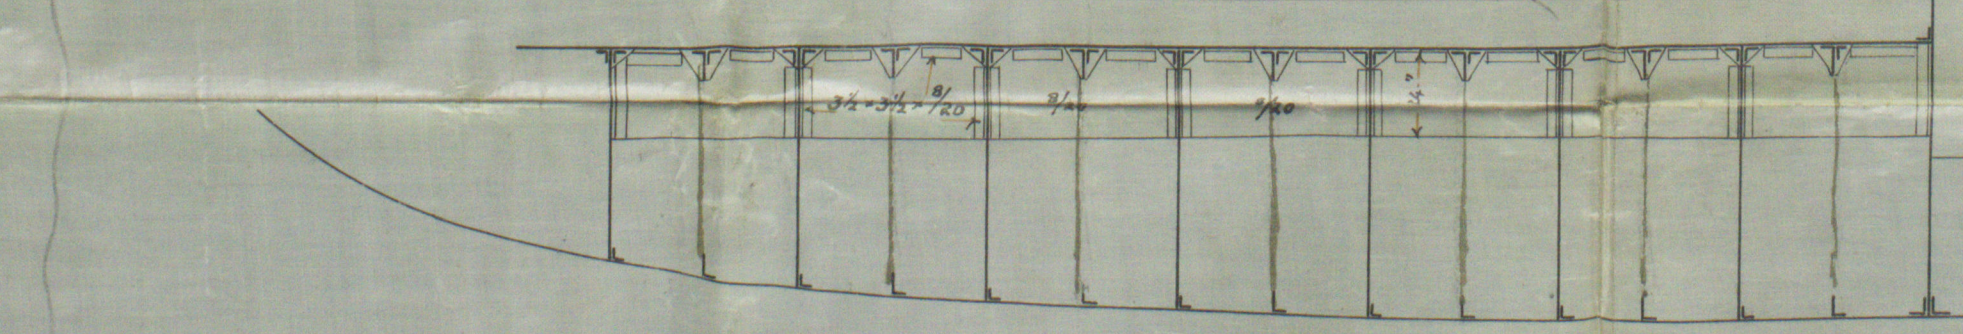

PLAN OF TANK TOP

