


Dr. 8 7 92

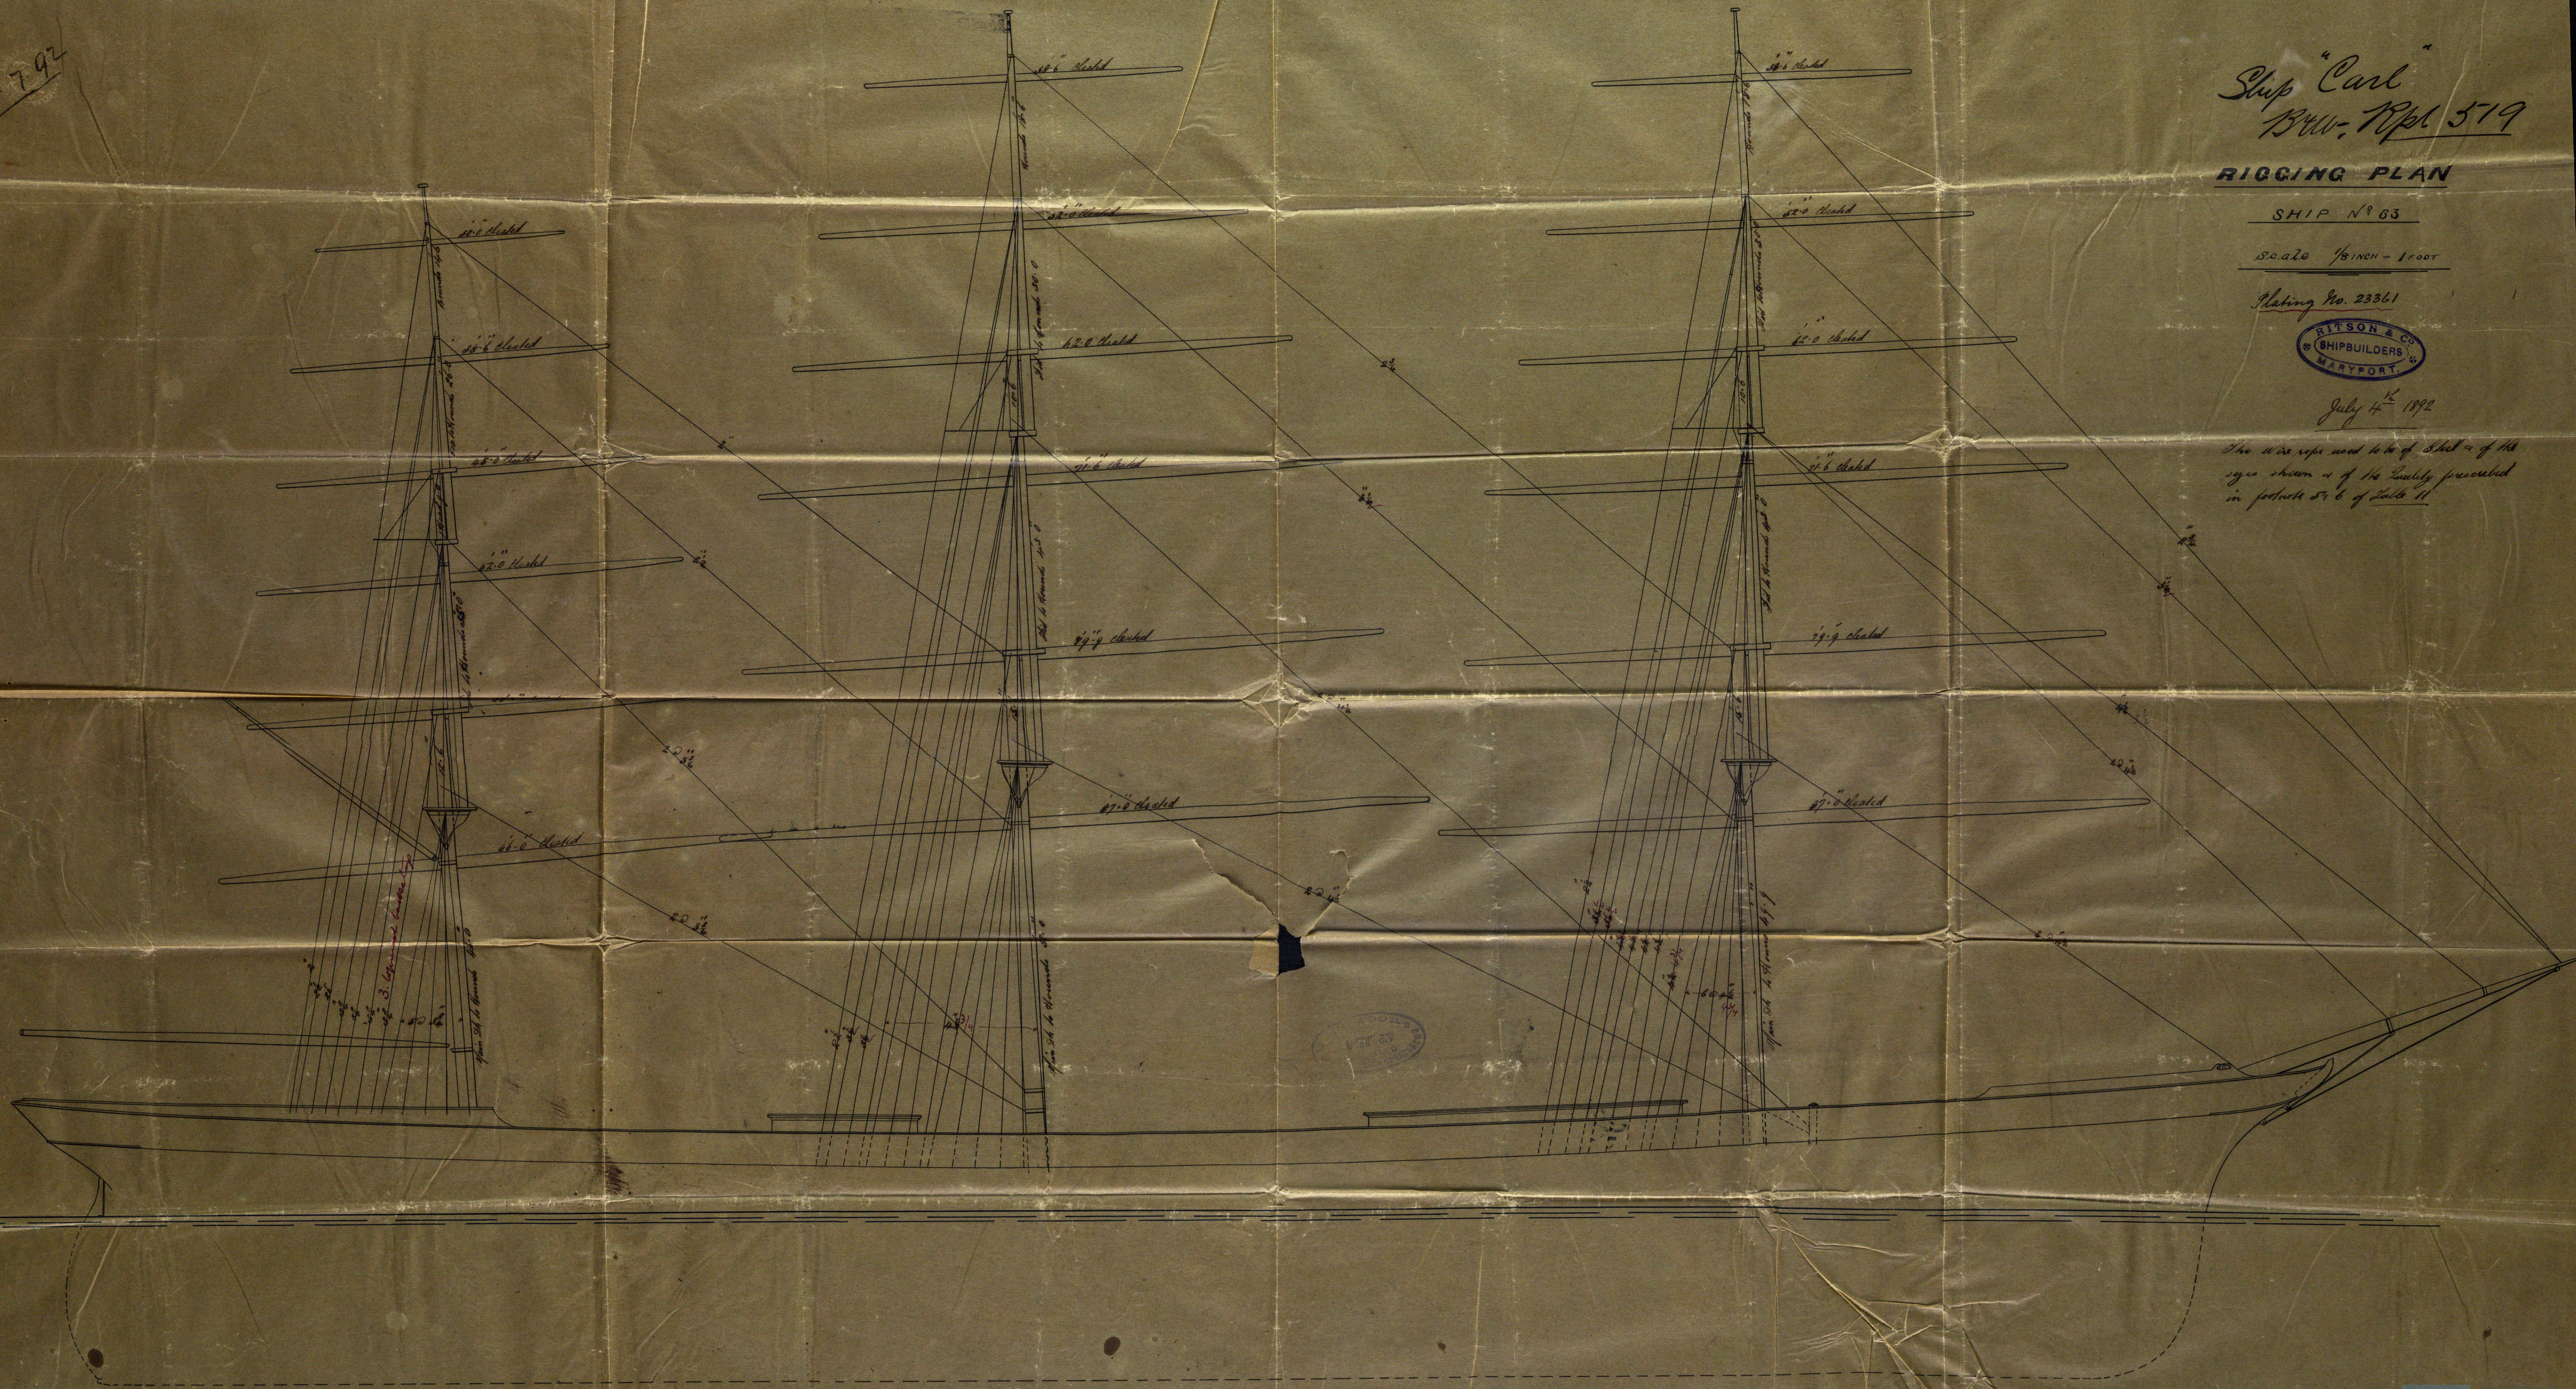

Ship "Carl"
B.W. No. 379

RIGGING PLAN

SHIP N° 63

Scale 1/8" = 1' 00"

Plating No. 23361



July 4th 1892

The wire rope used is to be of Steel or of the
size shown as of the quality prescribed
in footnote 5 of Table 11