

The words FORGINGS or CASTINGS, IRON or STEEL, should be struck out as may be required.

*Whitaker* Lloyd's Register of British and Foreign Shipping.

(Report on Vessel No. \_\_\_\_\_ Port \_\_\_\_\_)

No. *2121 a*

SHIP FORGINGS OR CASTINGS.

I have to report that the undermentioned Iron or Steel Forgings or Castings, manufactured by  
*the Portlinton Forge Co.* of *Portlinton*  
 for the Vessel No. *63*, being built by *Imperial Pattern Co.*  
 of *Mayport* have been inspected by me as set forth below, and found  
 to be, so far as can be seen, *sound*.

Mark on Forgings.

Lloyd's

No. *2121 a*

No. *6*



*Hugh Cameron*

*Lincolnton*

*11. 6. 92*

	STERN FRAME.	RUDDER FRAME.	STEM.
Material* - - - -	<i>Scrap iron</i>	<i>Scrap iron</i>	<i>Scrap iron</i>
How made - - - -	<i>Forged</i>	<i>Forged</i>	<i>Forged</i>
Dimensions - - - -	<i>10" x 2 5/8"</i>	<i>7" x 3 1/2"</i>	<i>10" x 2 5/8"</i>
Progress on Inspection -	<i>Forged &amp; riveted</i>	<i>Forged &amp; riveted</i>	<i>Forged</i>
Dates when Inspected	<i>July 11<sup>th</sup> to Feb 8/92</i>	<i>May 13<sup>th</sup> to June 2/92</i>	<i>Oct 7/91</i>

SKETCHES OF FRAMES SHEWING POSITION AND DESCRIPTION OF WELDS OF FORGINGS, OR PARTICULARS OF TESTS APPLIED TO CASTINGS.

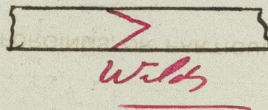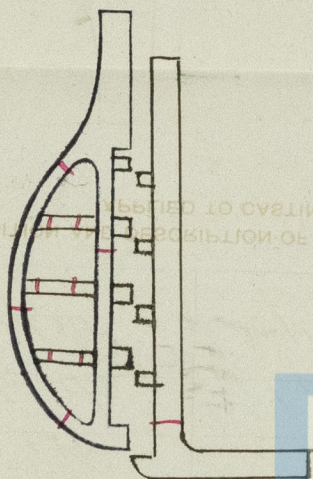

*Welds*

© 2019

Lloyd's Register  
Foundation

BRW42-0088

\* If of Iron, state whether scrap or puddled Iron.